


T. 32 S., R. 4 W., W. M.

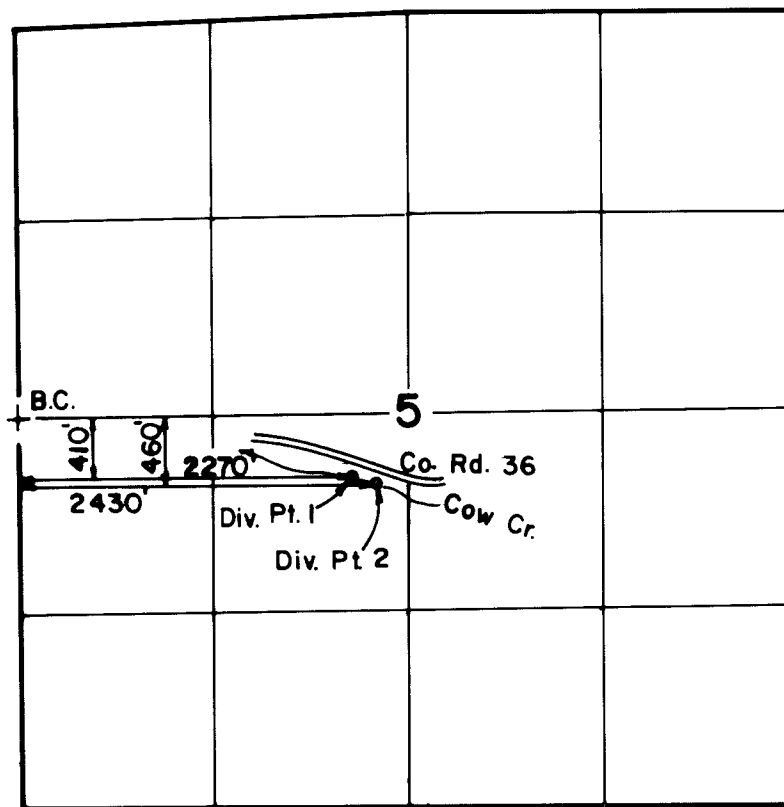

Scale: 1" = 1320'

**FINAL PROOF SURVEY
UNDER**

TRANSFER NO. 5931
Application No. Permit No.
IN NAME OF

..CHARLES WILLIAM VAN SICKLE..

Surveyed JULY 10, 1990, by B. S. JAMES