


T. I. S., R. I. W., W. M.

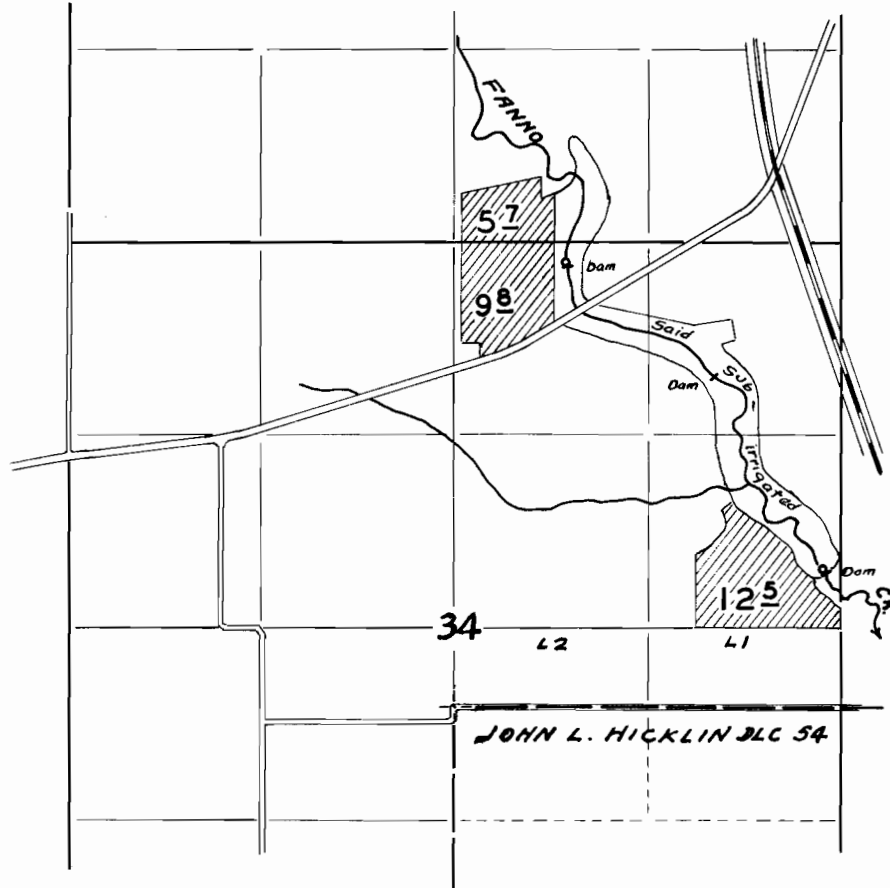

**FINAL PROOF SURVEY**  
UNDER

Application No. 24593 Permit No. 19376  
IN NAME OF

C. L. ROBINSON

Surveyed 4 - 17, 1956, by M. BISH