


T.20S.R.3W.W.M.

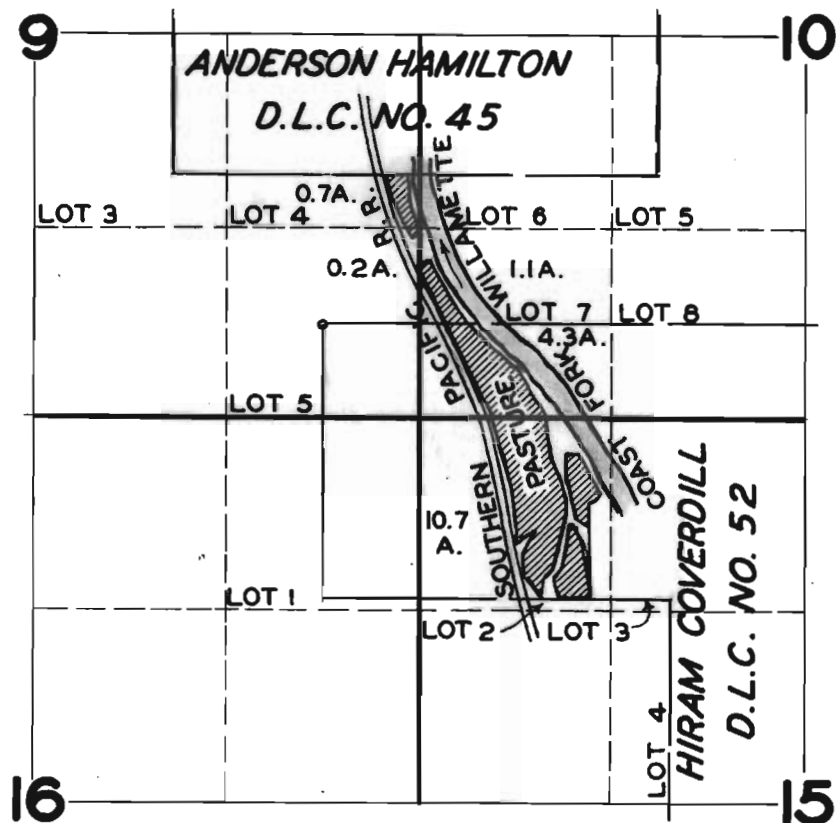

FINAL PROOF SURVEY
UNDER

Application No. 22482 Permit No. 17722
IN NAME OF

JAMES M. CHATTERTON

Surveyed JUL. 19. 1948, by JAS. E. BUNNELL