


T. 6N. R. 35E.W.M.

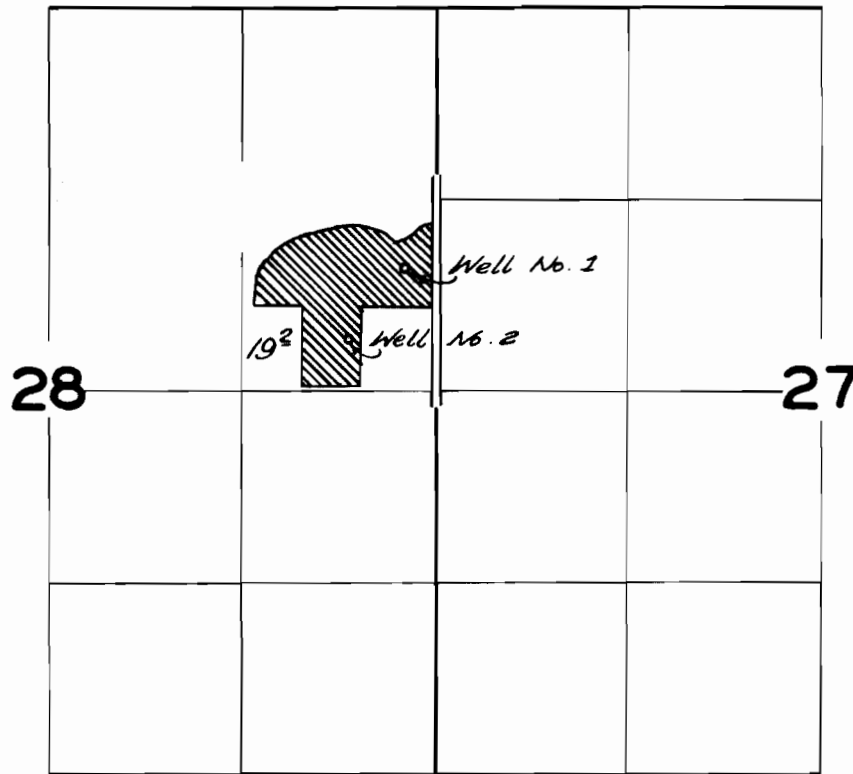

FINAL PROOF SURVEY

UNDER

Application No. *G-972* Permit No. *G-864*

IN NAME OF

*Walter J. Rand*

Surveyed *Oct 28 1959*, by *C.O. Burtels*