


SECTION

NE $\frac{1}{4}$ of NE $\frac{1}{4}$
of Sec 14

Oregon State Water Filings

Table Top
Reservoir

TOWNSHIP 22S, RANGE 38E, W. M.

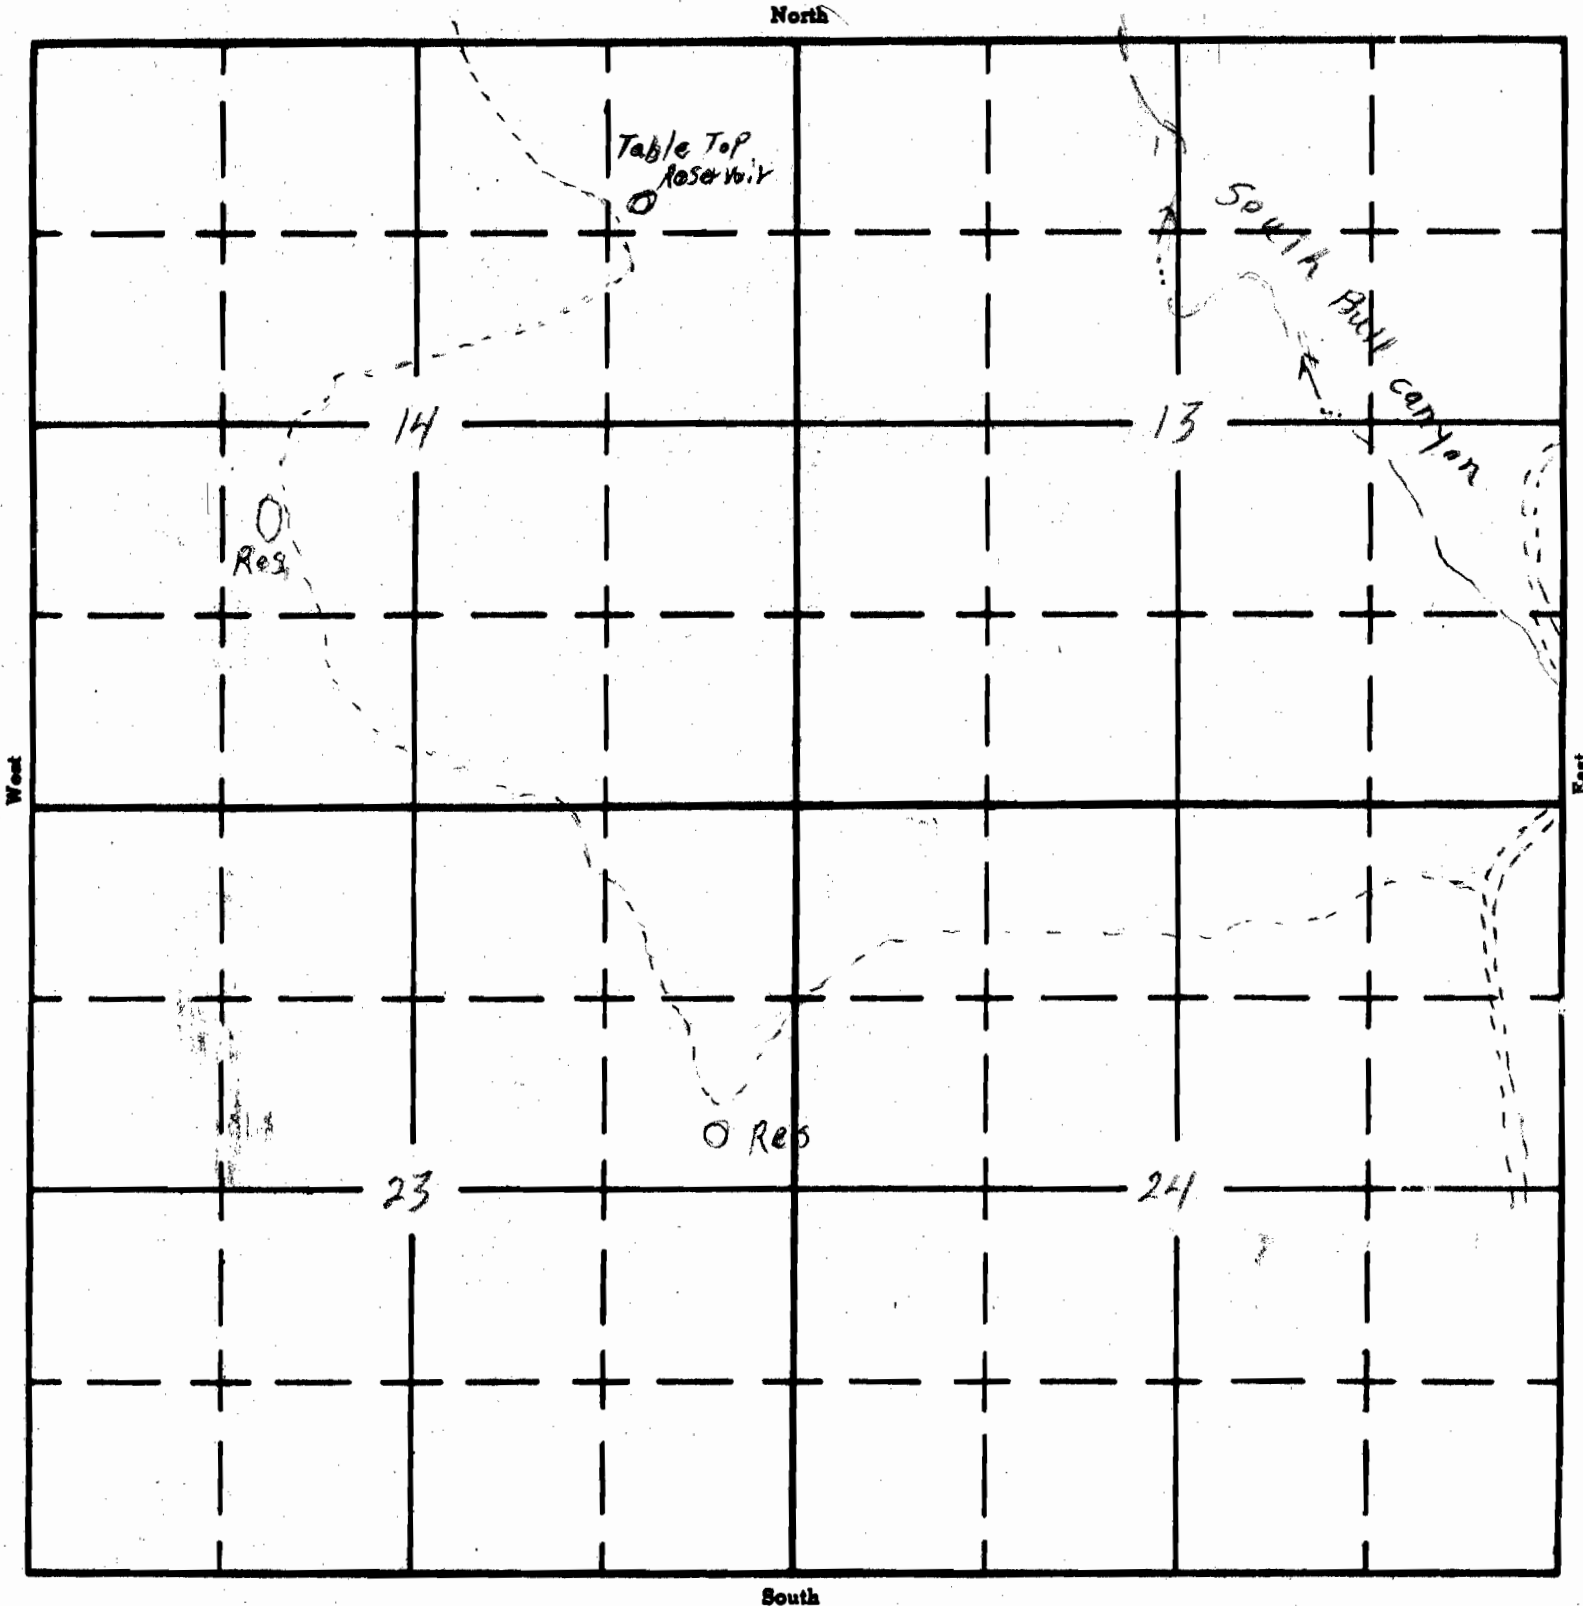


RECEIVED

79

WATER
S.

EST

T. 20 S. R. 40 E. W.M.

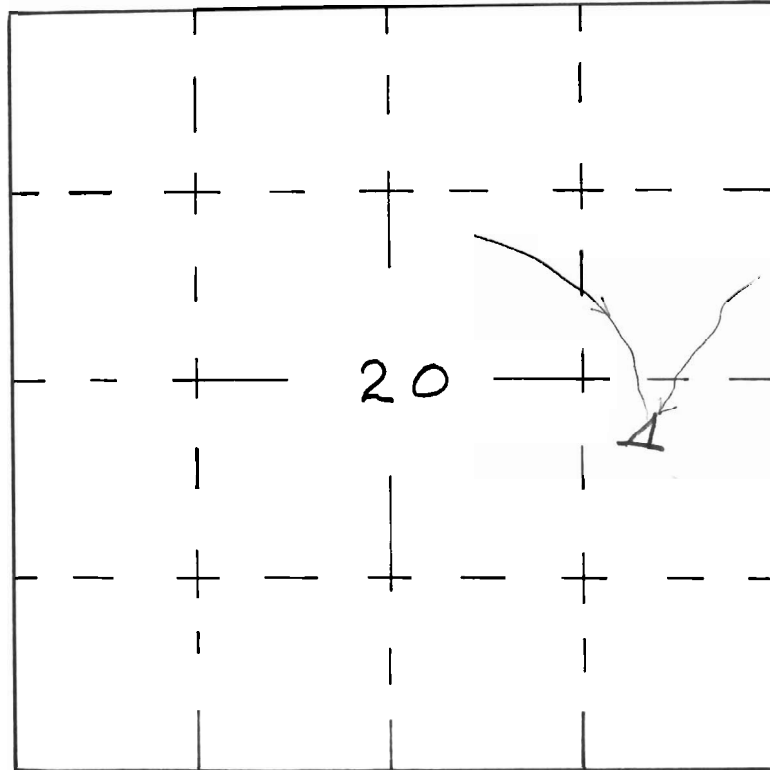

Application No. **R59082**

Permit No. **R 8724**

U. S. DEPARTMENT OF THE INTERIOR
BUREAU OF LAND MANAGEMENT

FOURBIT

DESIGNED _____

RECOMM. _____

DRAWN _____

RECOMM. _____

CHIEF, DIV. OF ENG.

CHECKED _____

APPROVED _____

SCALE _____

DATE _____

SHEET _____ OF _____

DRAWING NO. _____