

UNITED STATES
DEPARTMENT OF THE INTERIOR
BUREAU OF LAND MANAGEMENT

FAVORITE RES.

SECTION

24 SWSE

Oregon State Water Filings

TOWNSHIP 30 S, RANGE 37 E, W. M.

RECEIVED


SEP 30 1983

WATER RESOURCES DEPT.
SALEM, OREGON

R37E

North

R38

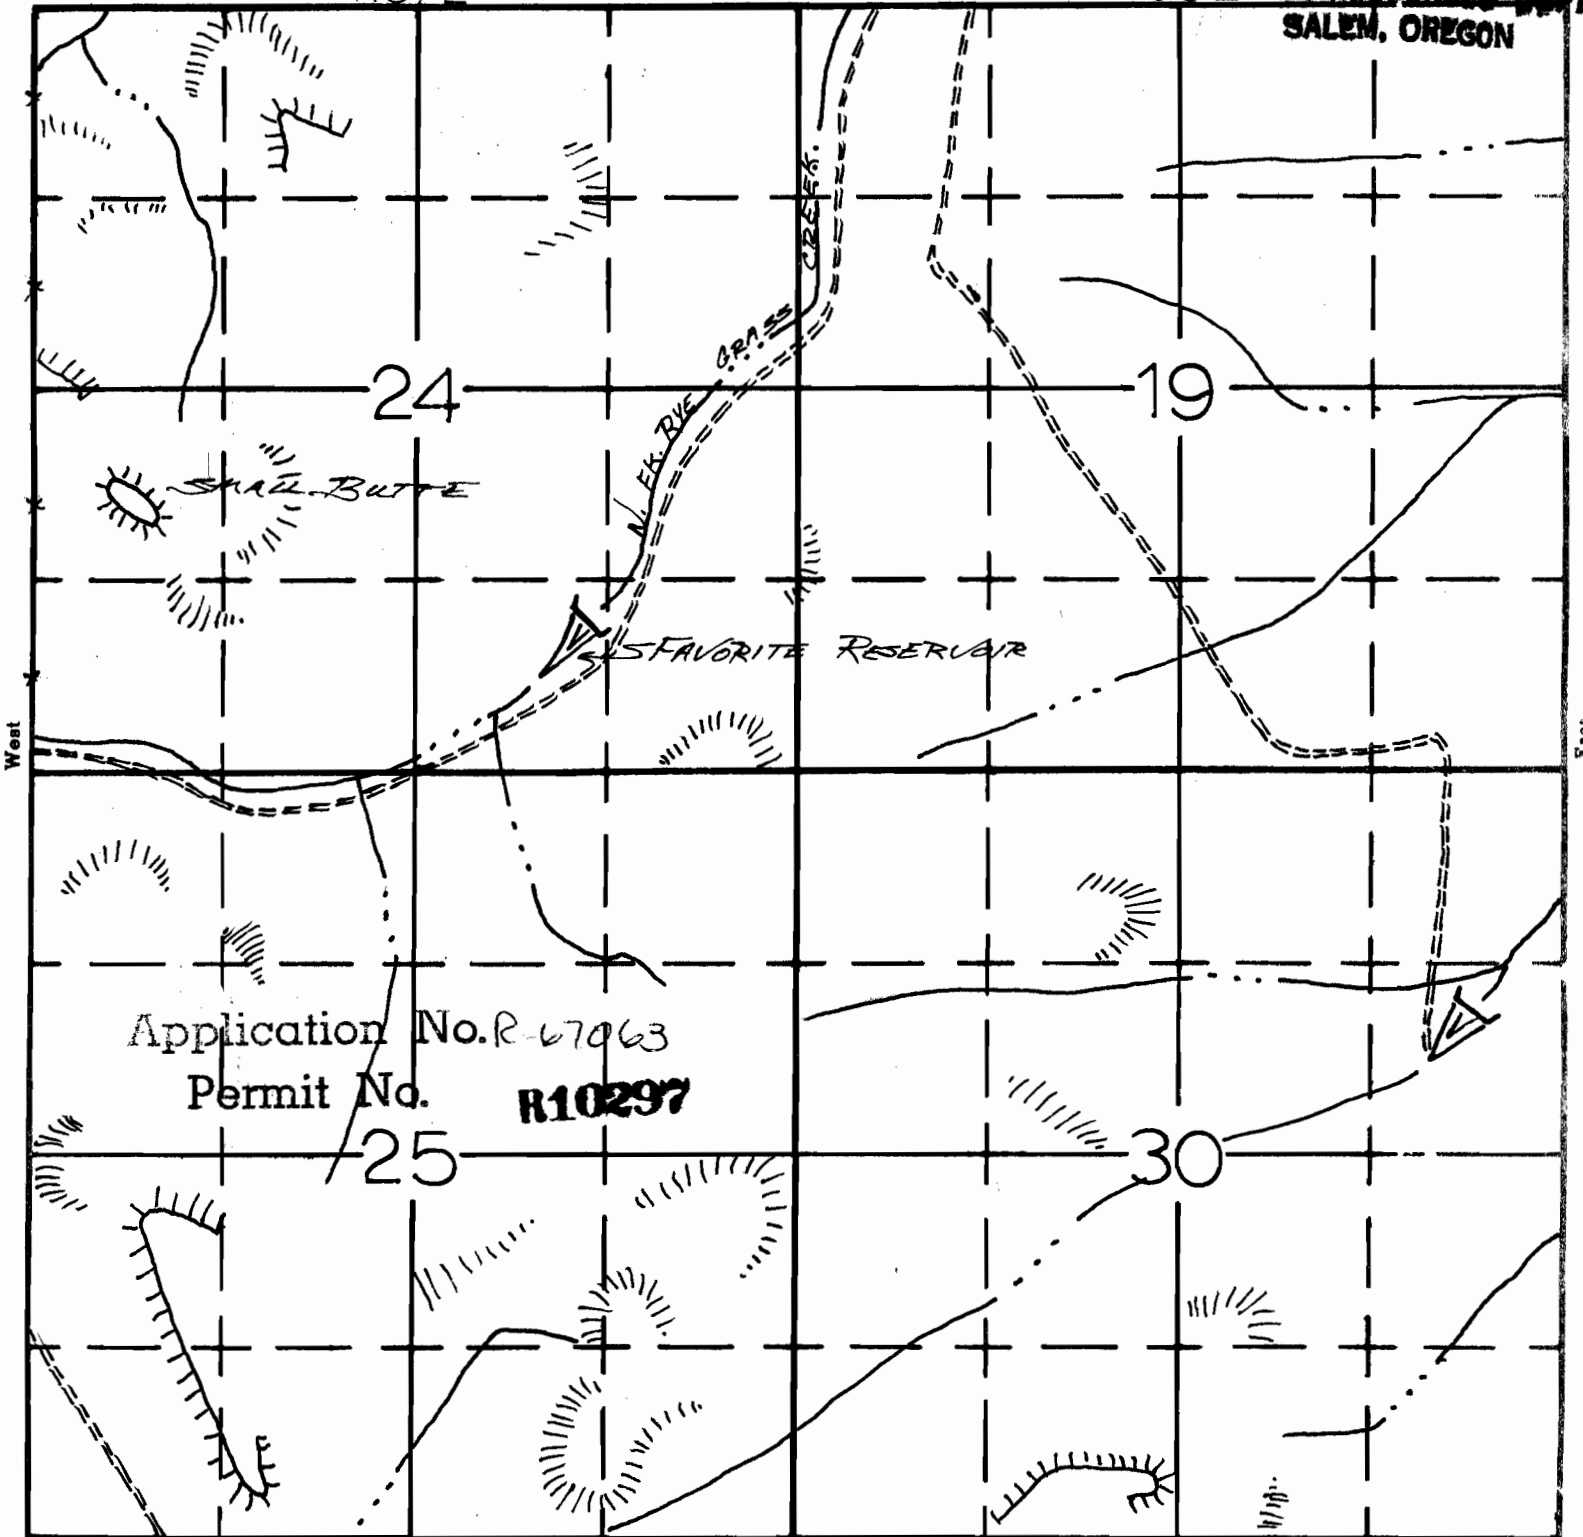

Application No. R-67063

Permit No. R10297

South

APPLICATION No.

PERMIT No.