

Form AI-187  
March 1961

UNITED STATES  
DEPARTMENT OF THE INTERIOR  
BUREAU OF LAND MANAGEMENT

SECTION

15


NW 1/4 & SW 1/4

# Oregon State Water Filings

TOWNSHIP 23S, RANGE 42E, W. M.

North

Wash Board Res

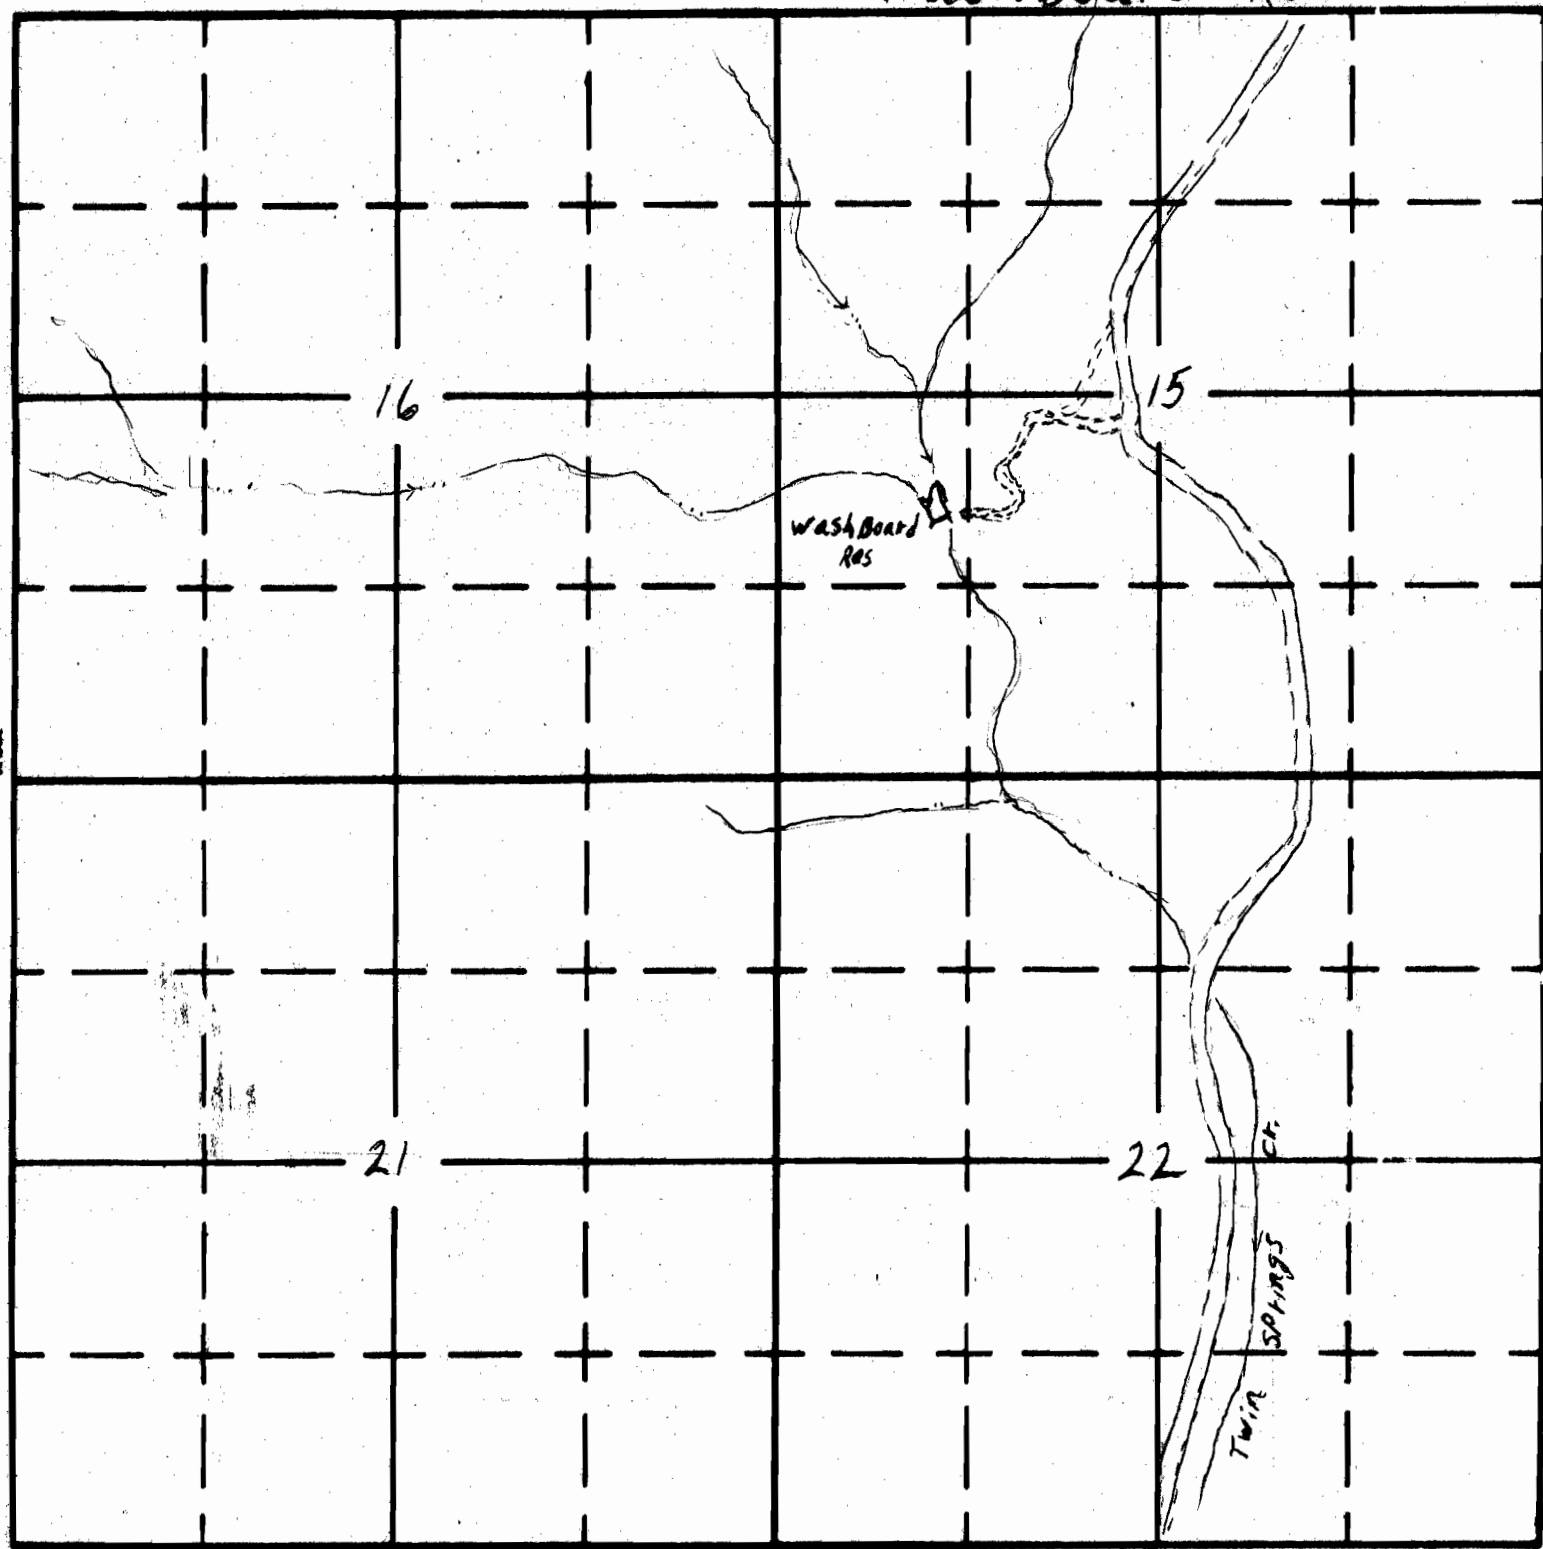

South

APPLICATION No. L-67808

PERMIT No. R10633