

Form A1-187
March 1961

UNITED STATES
DEPARTMENT OF THE INTERIOR
BUREAU OF LAND MANAGEMENT


SECTION

11
SW 1/4 NE 1/4

Oregon State Water Filings

TOWNSHIP 21S, RANGE 38E, W. M.

North Boney Basin Res. #1

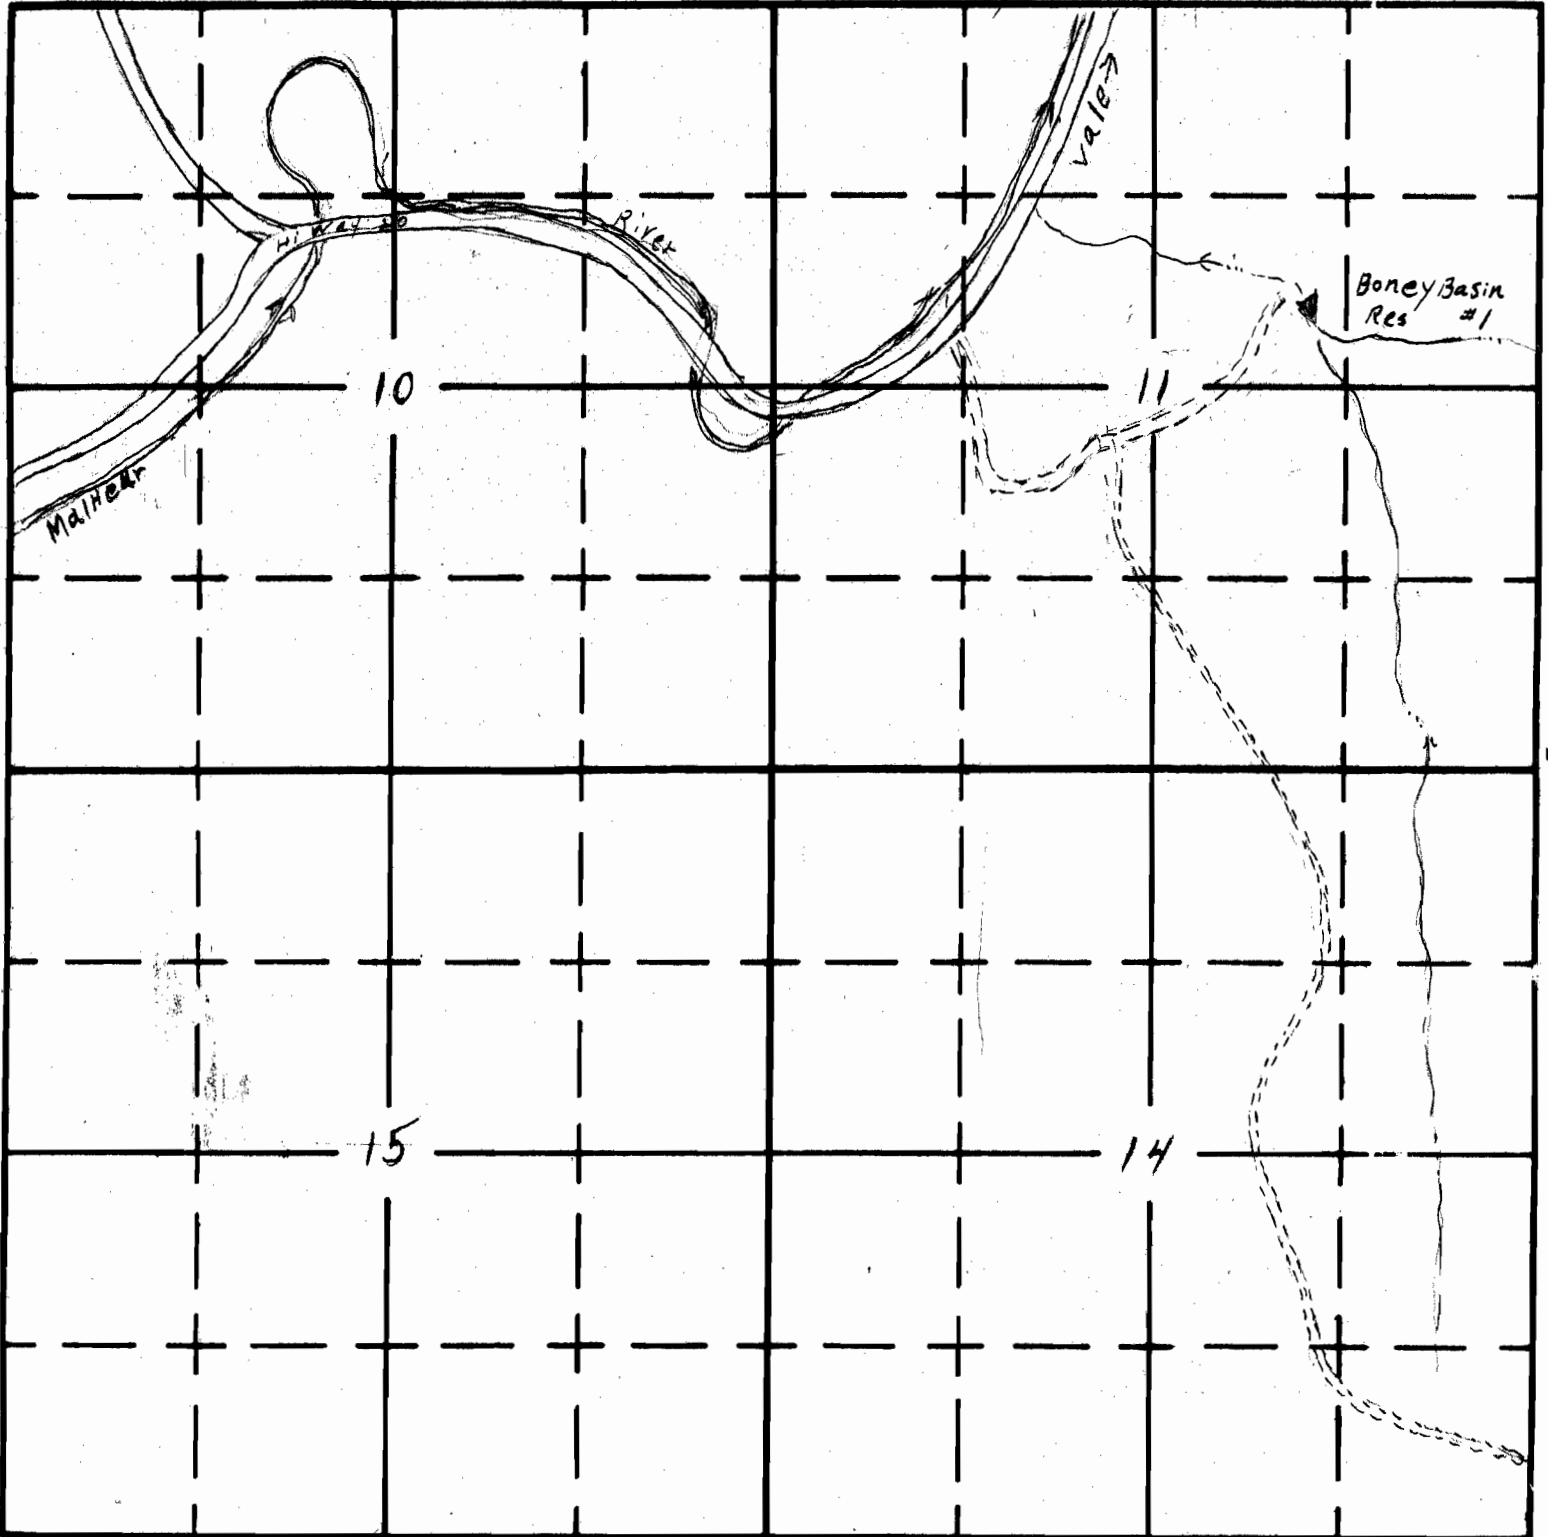

West

East

South

APPLICATION No. R-67810
PERMIT No. R10634