

Form AI-187
March 1961

UNITED STATES
DEPARTMENT OF THE INTERIOR
BUREAU OF LAND MANAGEMENT

SECTION

26


NW 1/4 SW 1/4

Oregon State Water Filings

TOWNSHIP 17S, RANGE 40E, W. M.

North

Ridge Road Res.

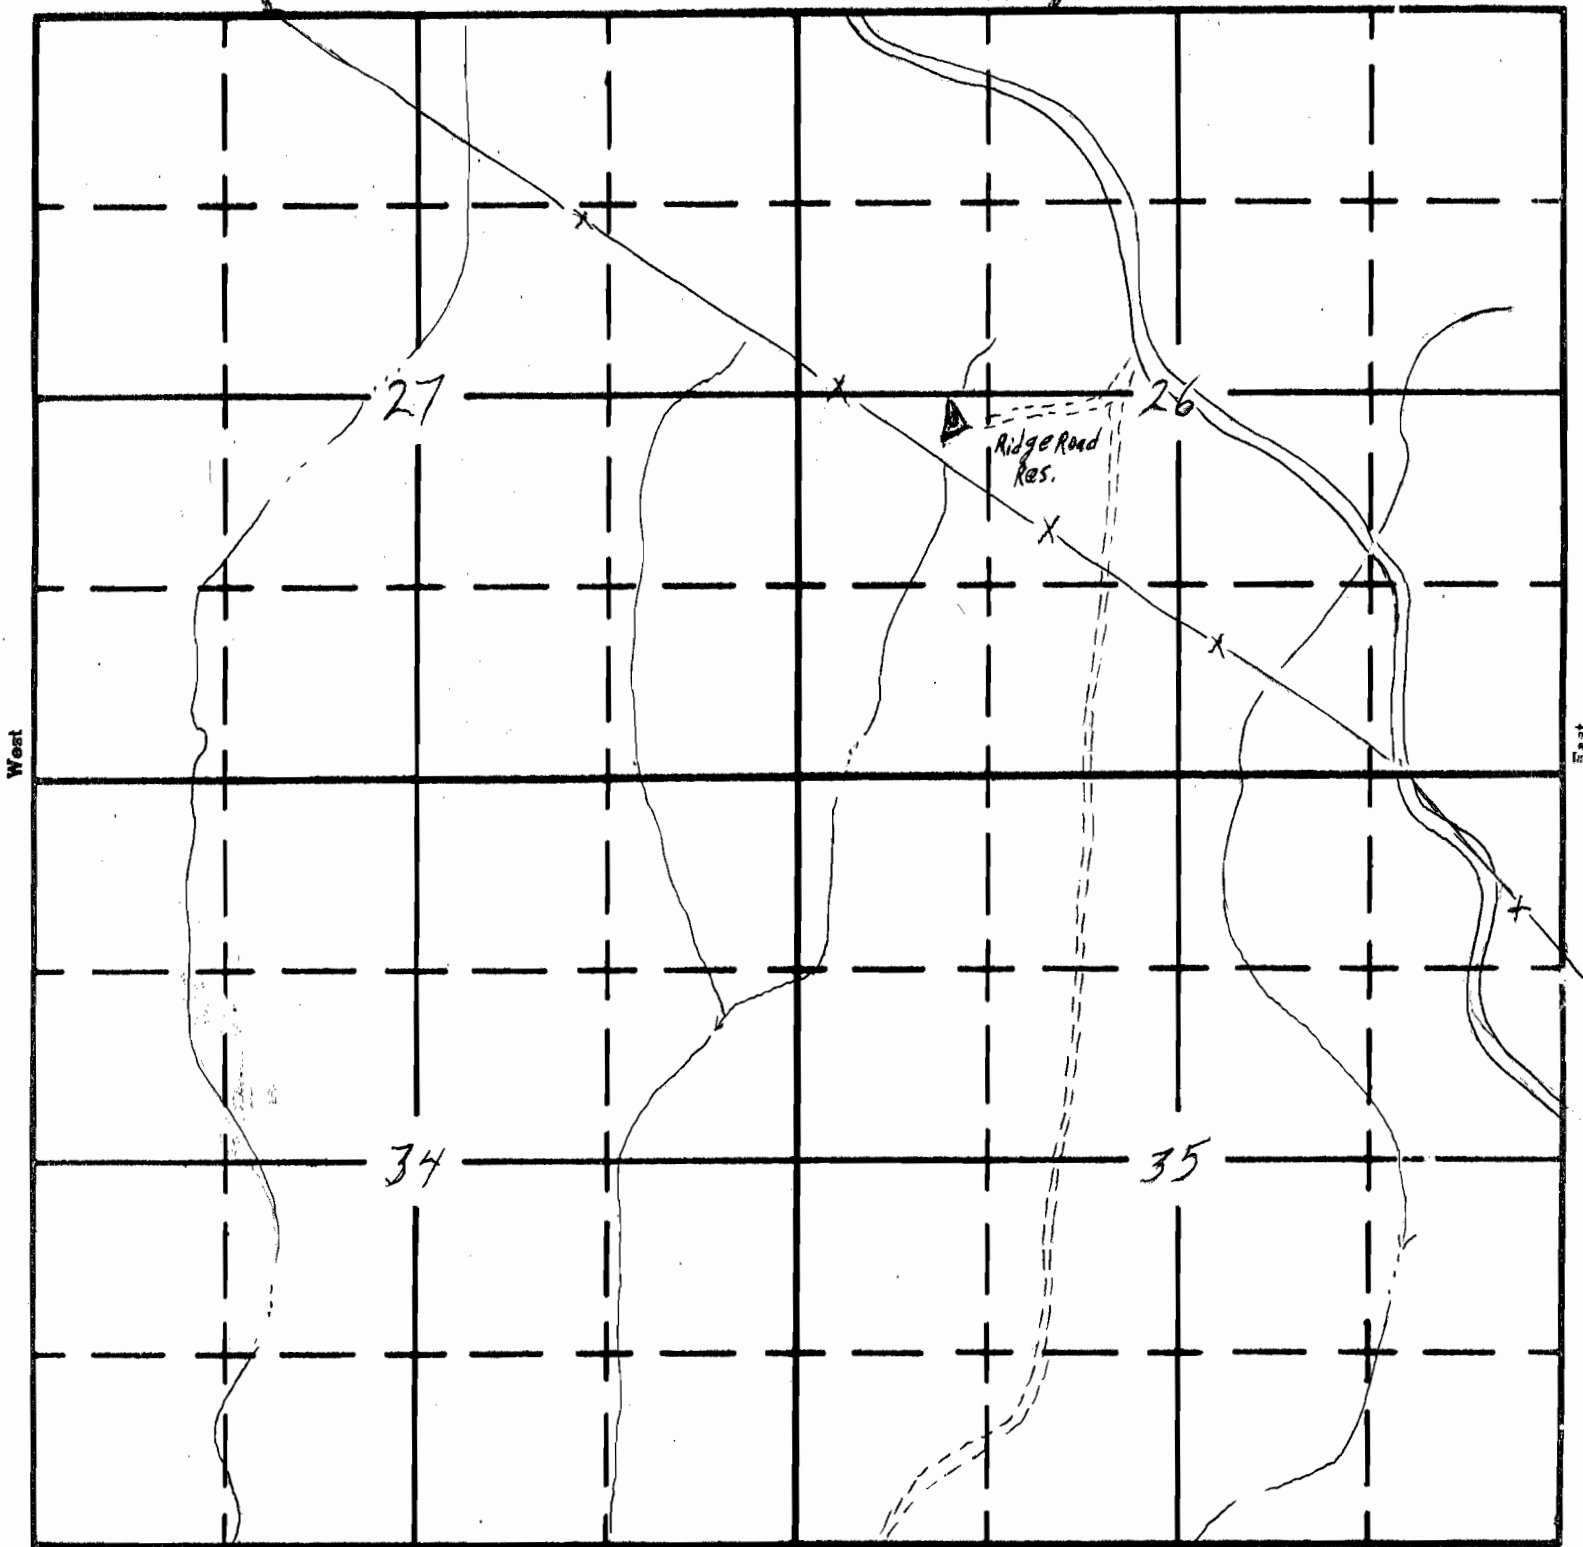

South

APPLICATION No. P-67818
PERMIT No. R10639