

UNITED STATES
DEPARTMENT OF THE INTERIOR
BUREAU OF LAND MANAGEMENT


SECTION

11
SW 1/4 NE 1/4

Oregon State Water Filings

TOWNSHIP 215, RANGE 38E, W. M.

North Boney Basin Res #2

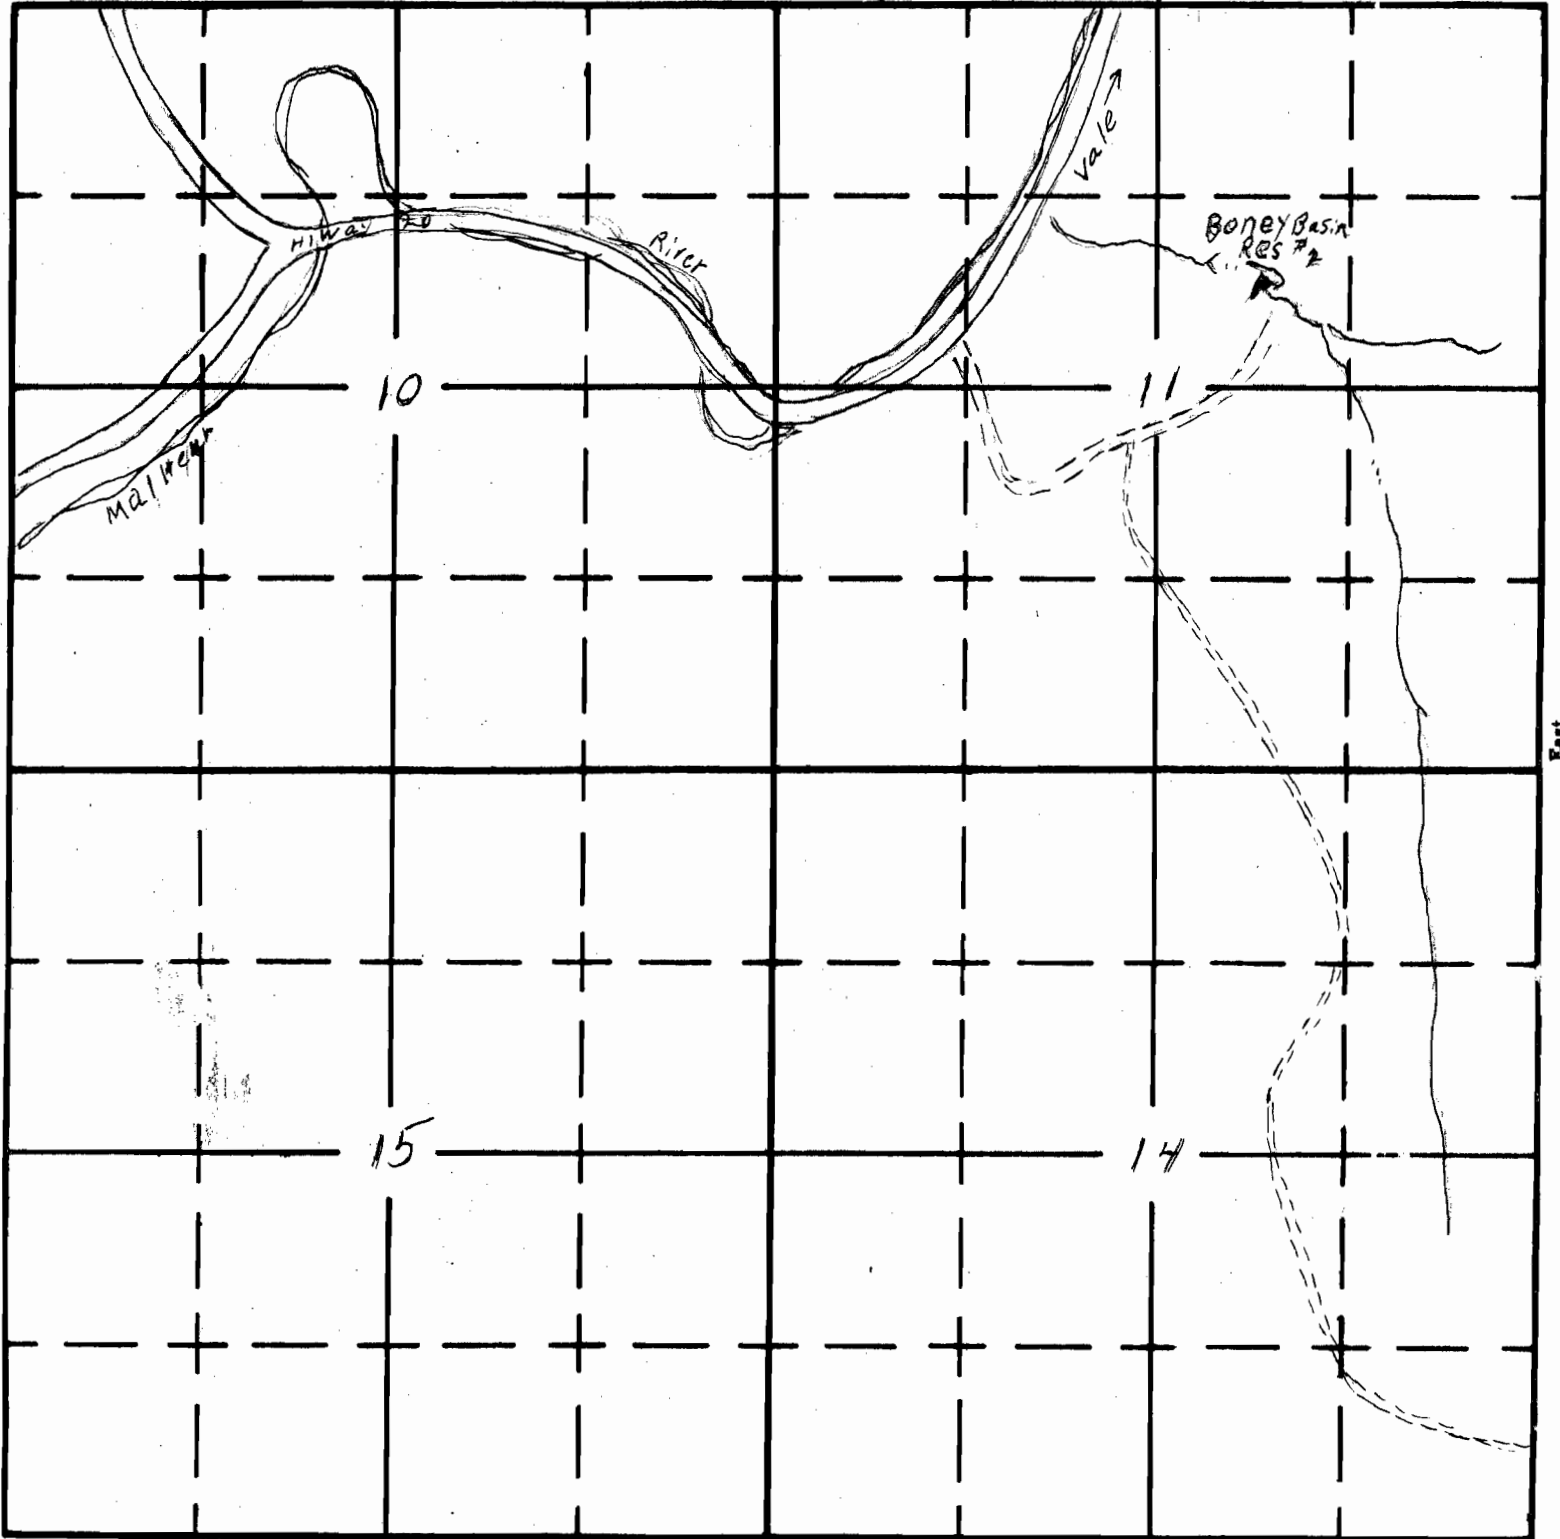

South