

Form A1-187
March 1961


UNITED STATES
DEPARTMENT OF THE INTERIOR
BUREAU OF LAND MANAGEMENT

SECTION
15 SWNW

Oregon State Water Filings

TOWNSHIP 20 S, RANGE 40 E, W. M.

North TUB SPRINGS RES

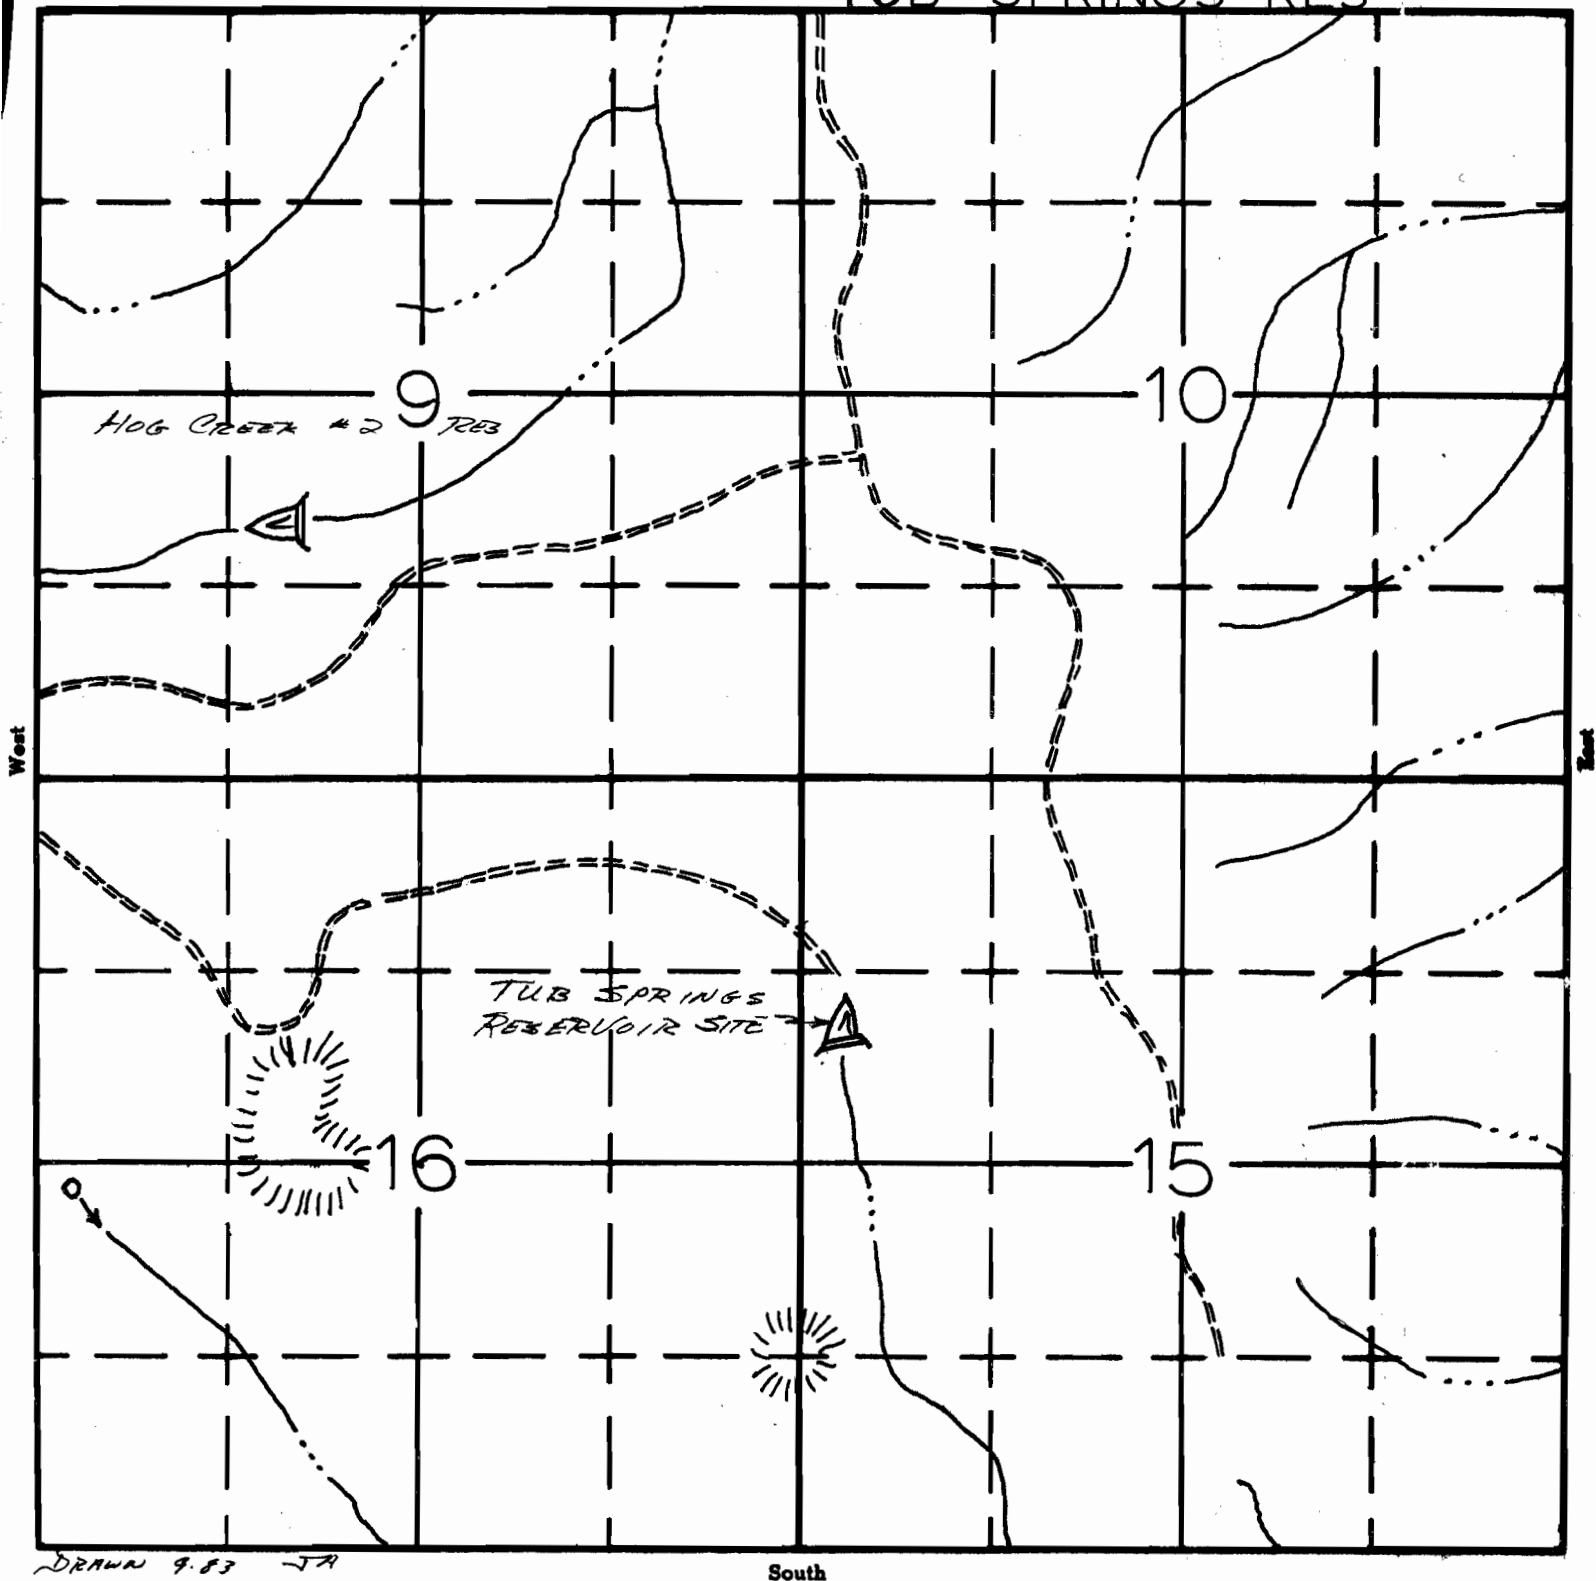

DRAWN 9.83 JA

APPLICATION No. 267821
PERMIT No. 10644