

Form AI-187  
March 1961

UNITED STATES  
DEPARTMENT OF THE INTERIOR  
BUREAU OF LAND MANAGEMENT

SECTION

22


# Oregon State Water Filings

SW  $\frac{1}{4}$  of SE  $\frac{1}{4}$

TOWNSHIP 22S, RANGE 41E, W. M.

North

MESA waterhole Res. (260)

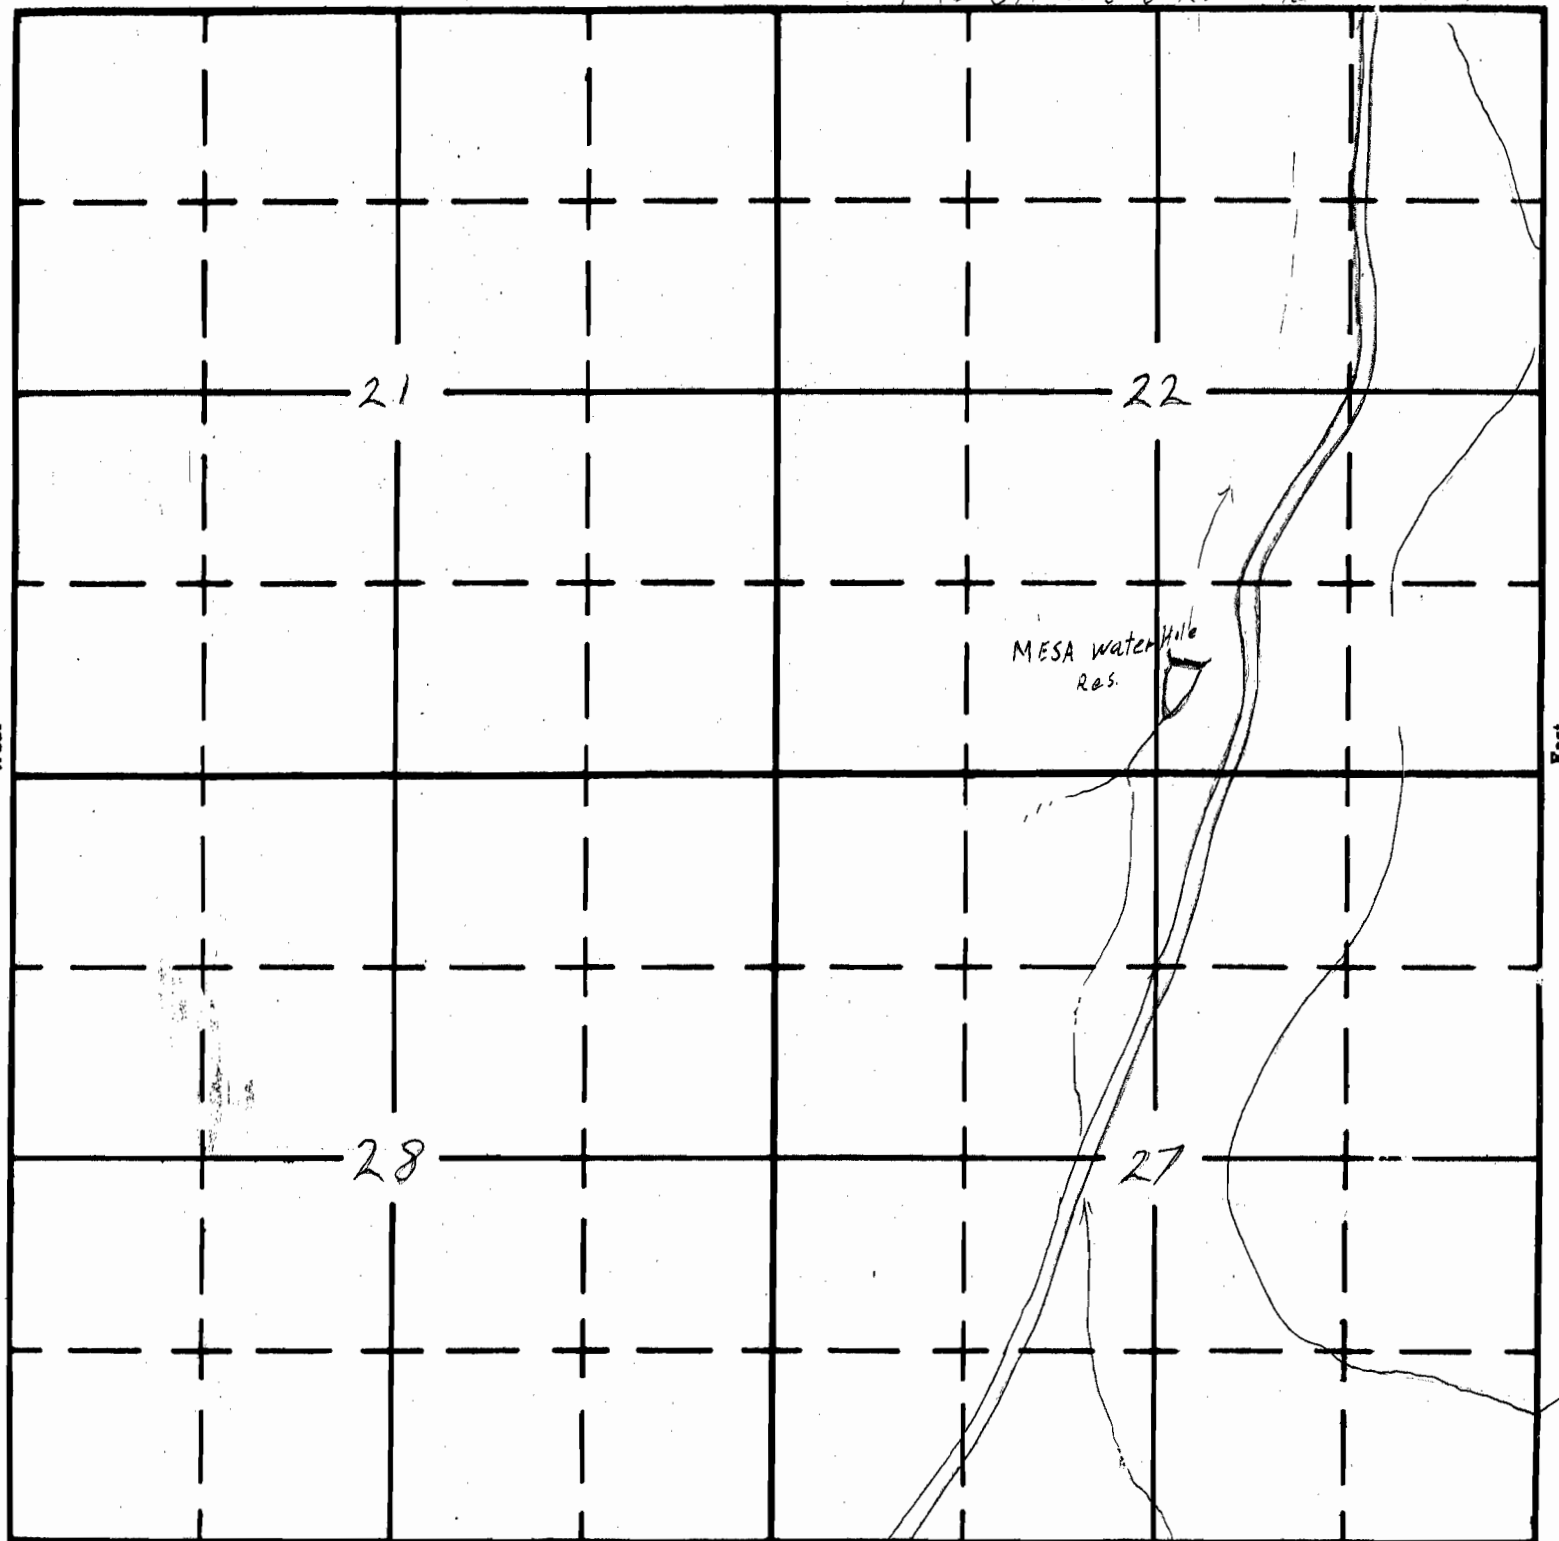

South

12-67838  
APPLICATION No. **R10656**  
PERMIT No.