


SECTION 33

TOWNSHIP 19S RANGE 38E W.M

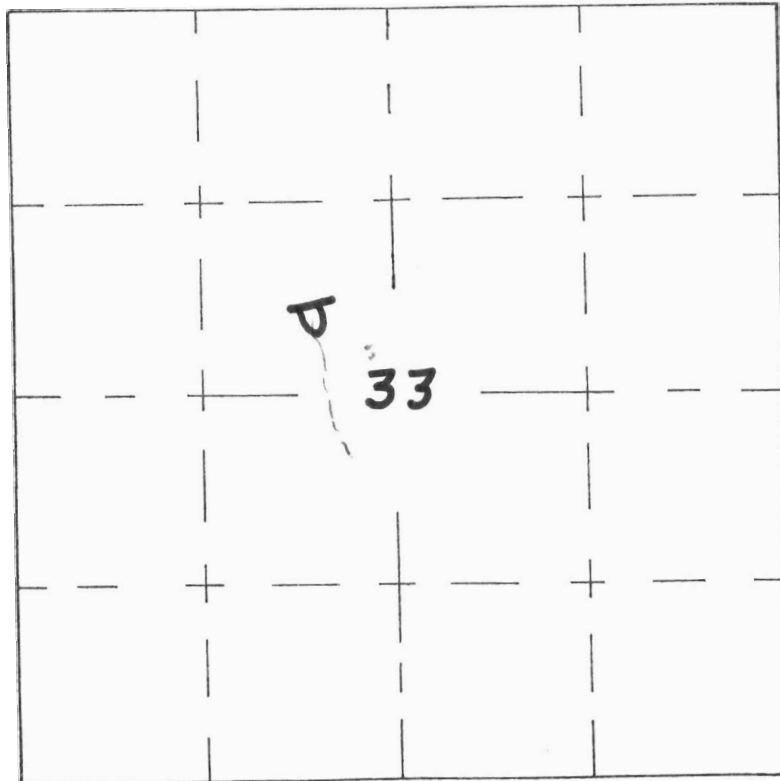

Burnt MTN.
No R59130

Permit No. R 8765