

RECEIVED


MAR 18 1993

WATER RES.
SALEM, ORE.

SECTION 27

SE 1/4 NE 1/4

TOWNSHIP 19^S RANGE 40^E W.M

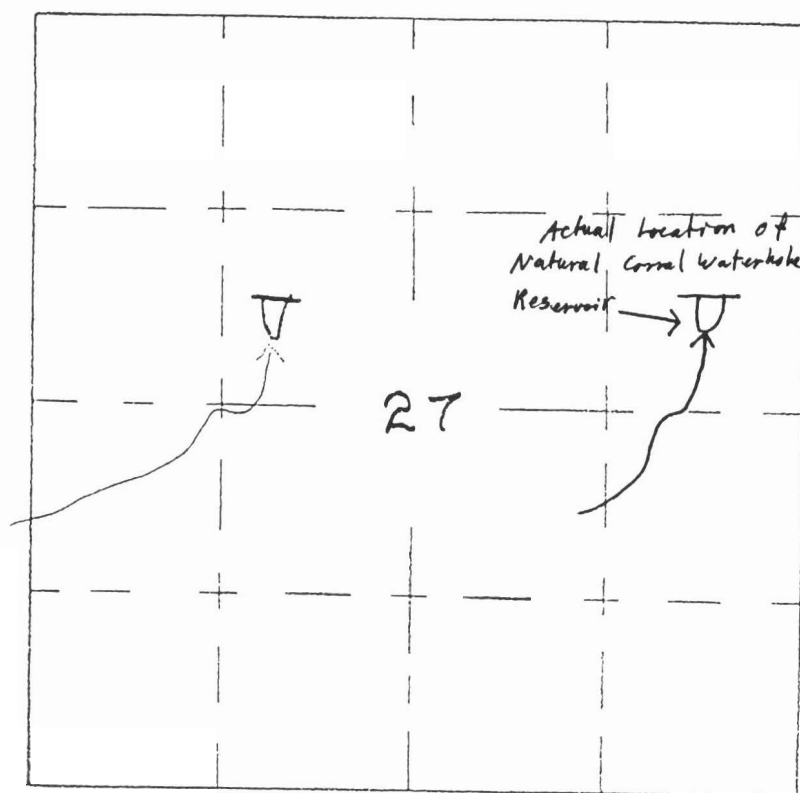

Application No. R59120
Permit No. R 8756

U. S. DEPARTMENT OF THE INTERIOR
BUREAU OF LAND MANAGEMENT

Natural Corral water hole

DESIGNED _____	RECOMM. _____
DRAWN _____	RECOMM. _____
CHECKED _____	APPROVED _____
SCALE _____	
DATE _____	SHEET _____ OF _____
DRAWING NO. _____	