


SECTION 11

NW $\frac{1}{4}$ NW $\frac{1}{4}$

TOWNSHIP 39S RANGE 39E W.M.

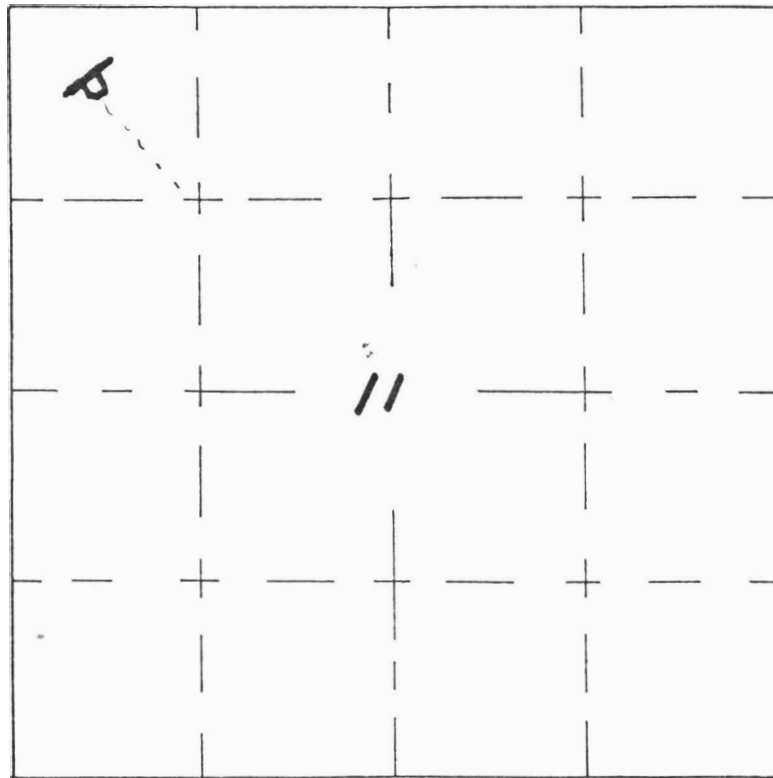

Juniper Res.
N^o R 59104

Permit No. R 8742