


SECTION 13

NE 1/4 SE 1/4

TOWNSHIP 22 S RANGE 38 E W.M.

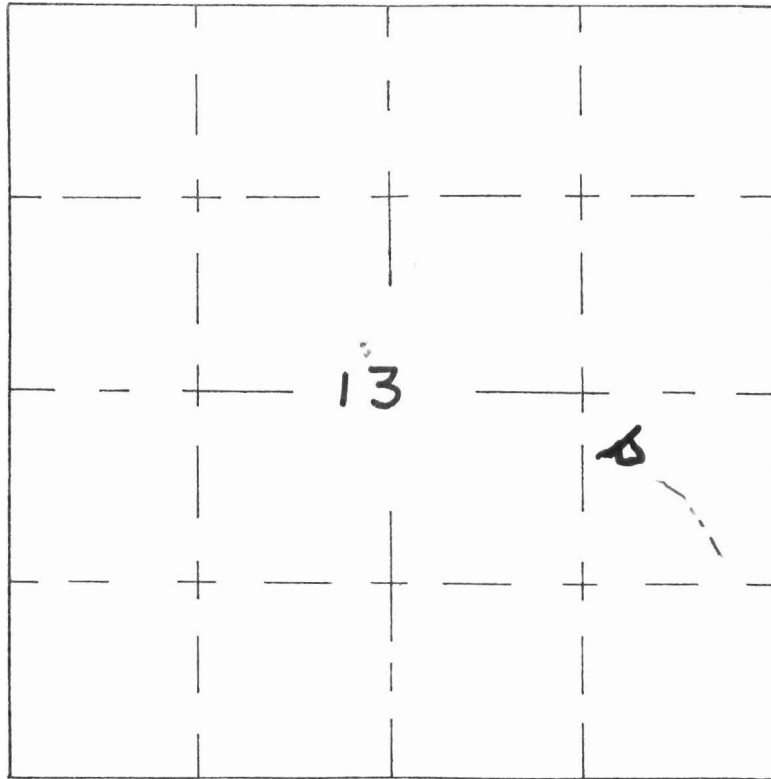

Sheep Camp Draw
No R 59060

Permit No. R 8705