

UNITED STATES
DEPARTMENT OF THE INTERIOR
BUREAU OF LAND MANAGEMENT


SECTION

Oregon State Water Filings

1
SW 1/4 NW 1/4

TOWNSHIP 39-S, RANGE 23-E, W. M.

North

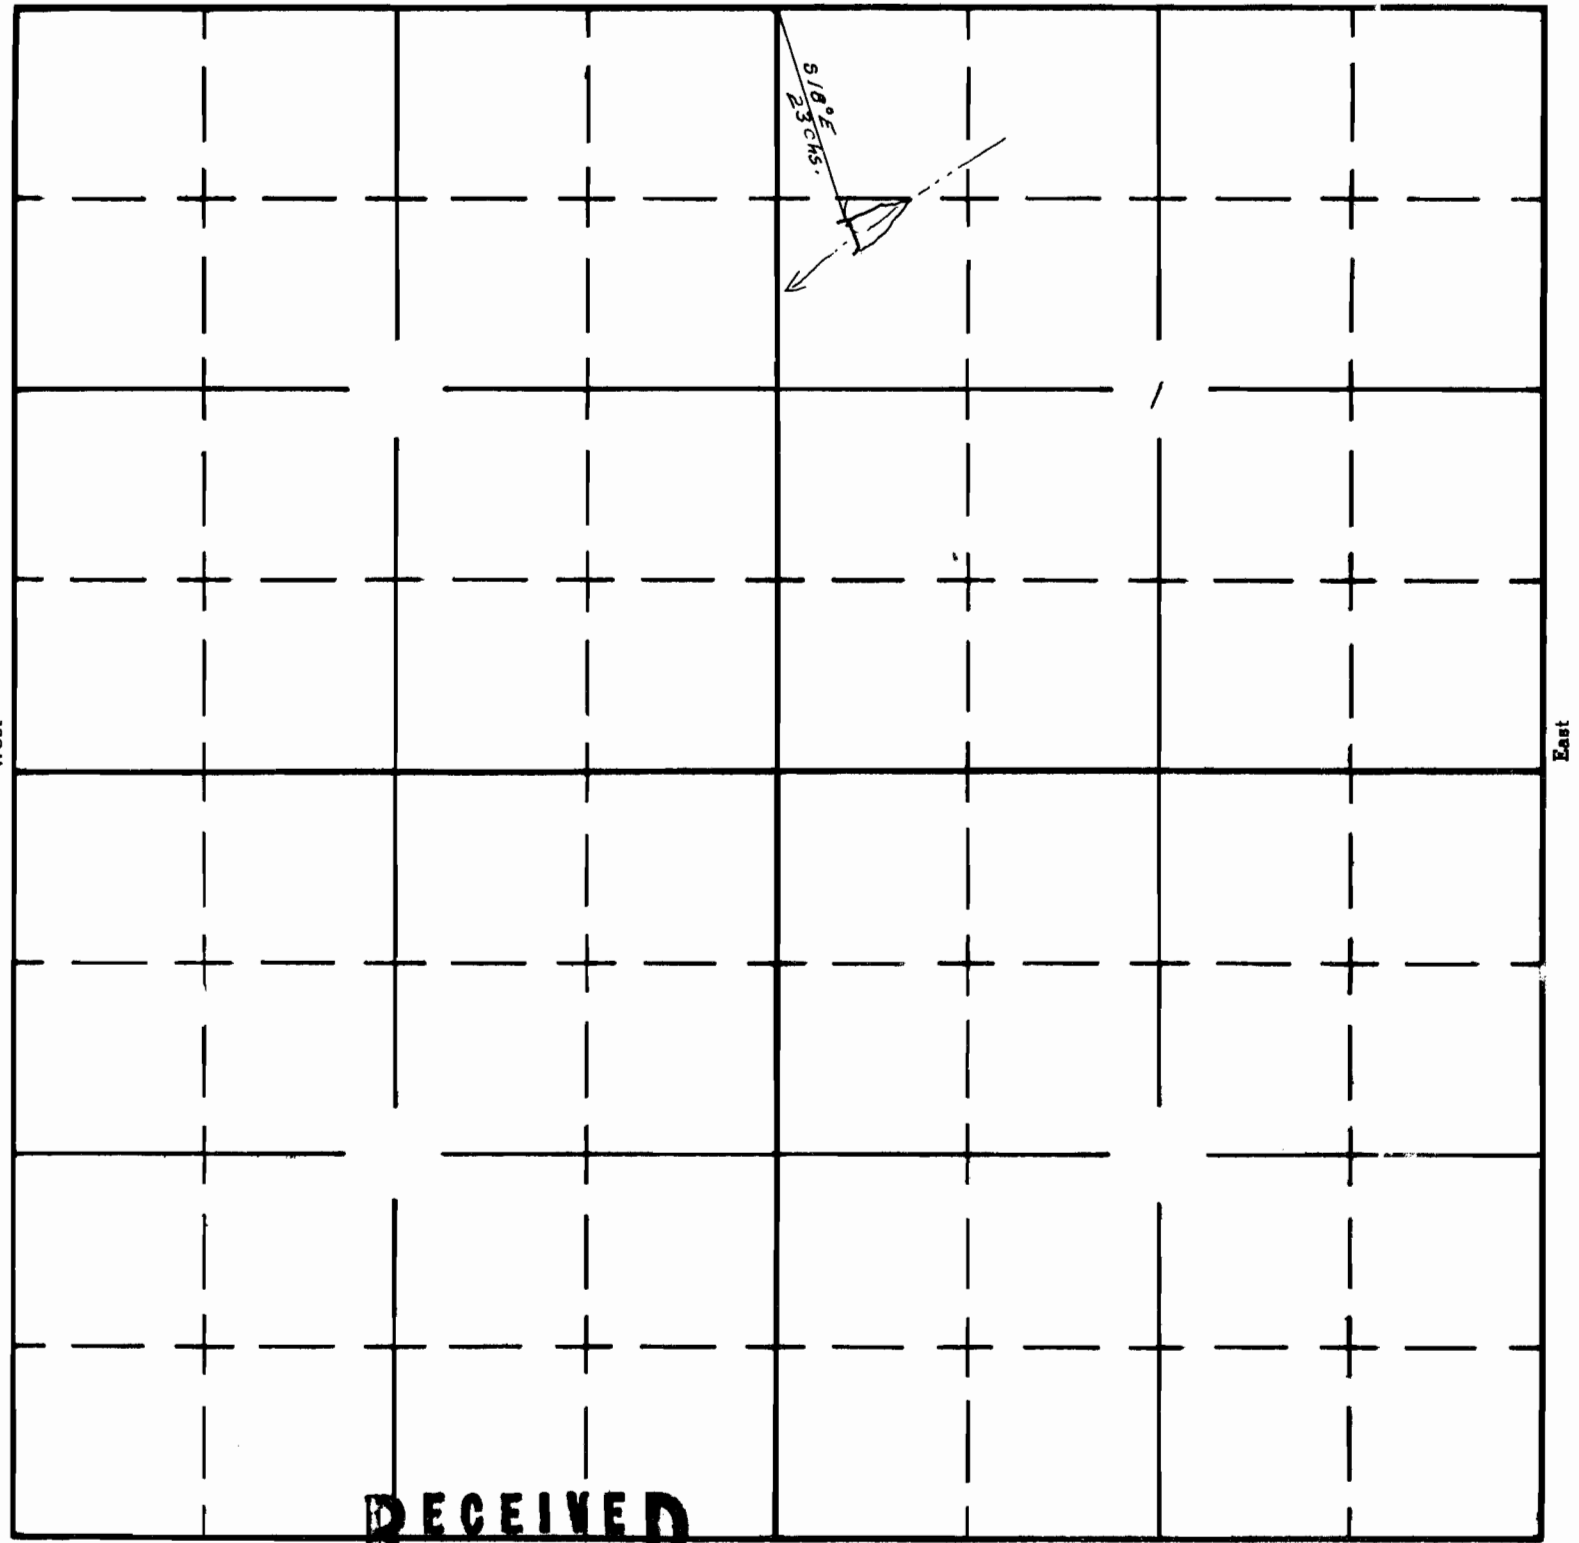

RECEIVED
JAN 29 1965

STATE ENGINEER
SALEM, OREGON

APPLICATION No. R-40557
PERMIT No. 7380