

Form AI-187
March 1961

UNITED STATES
DEPARTMENT OF THE INTERIOR
BUREAU OF LAND MANAGEMENT


SECTION 19

NE 1/4 NE 1/4

Oregon State Water Filings

TOWNSHIP 19S, RANGE 4/E, W. M.

North Hart Creek Res

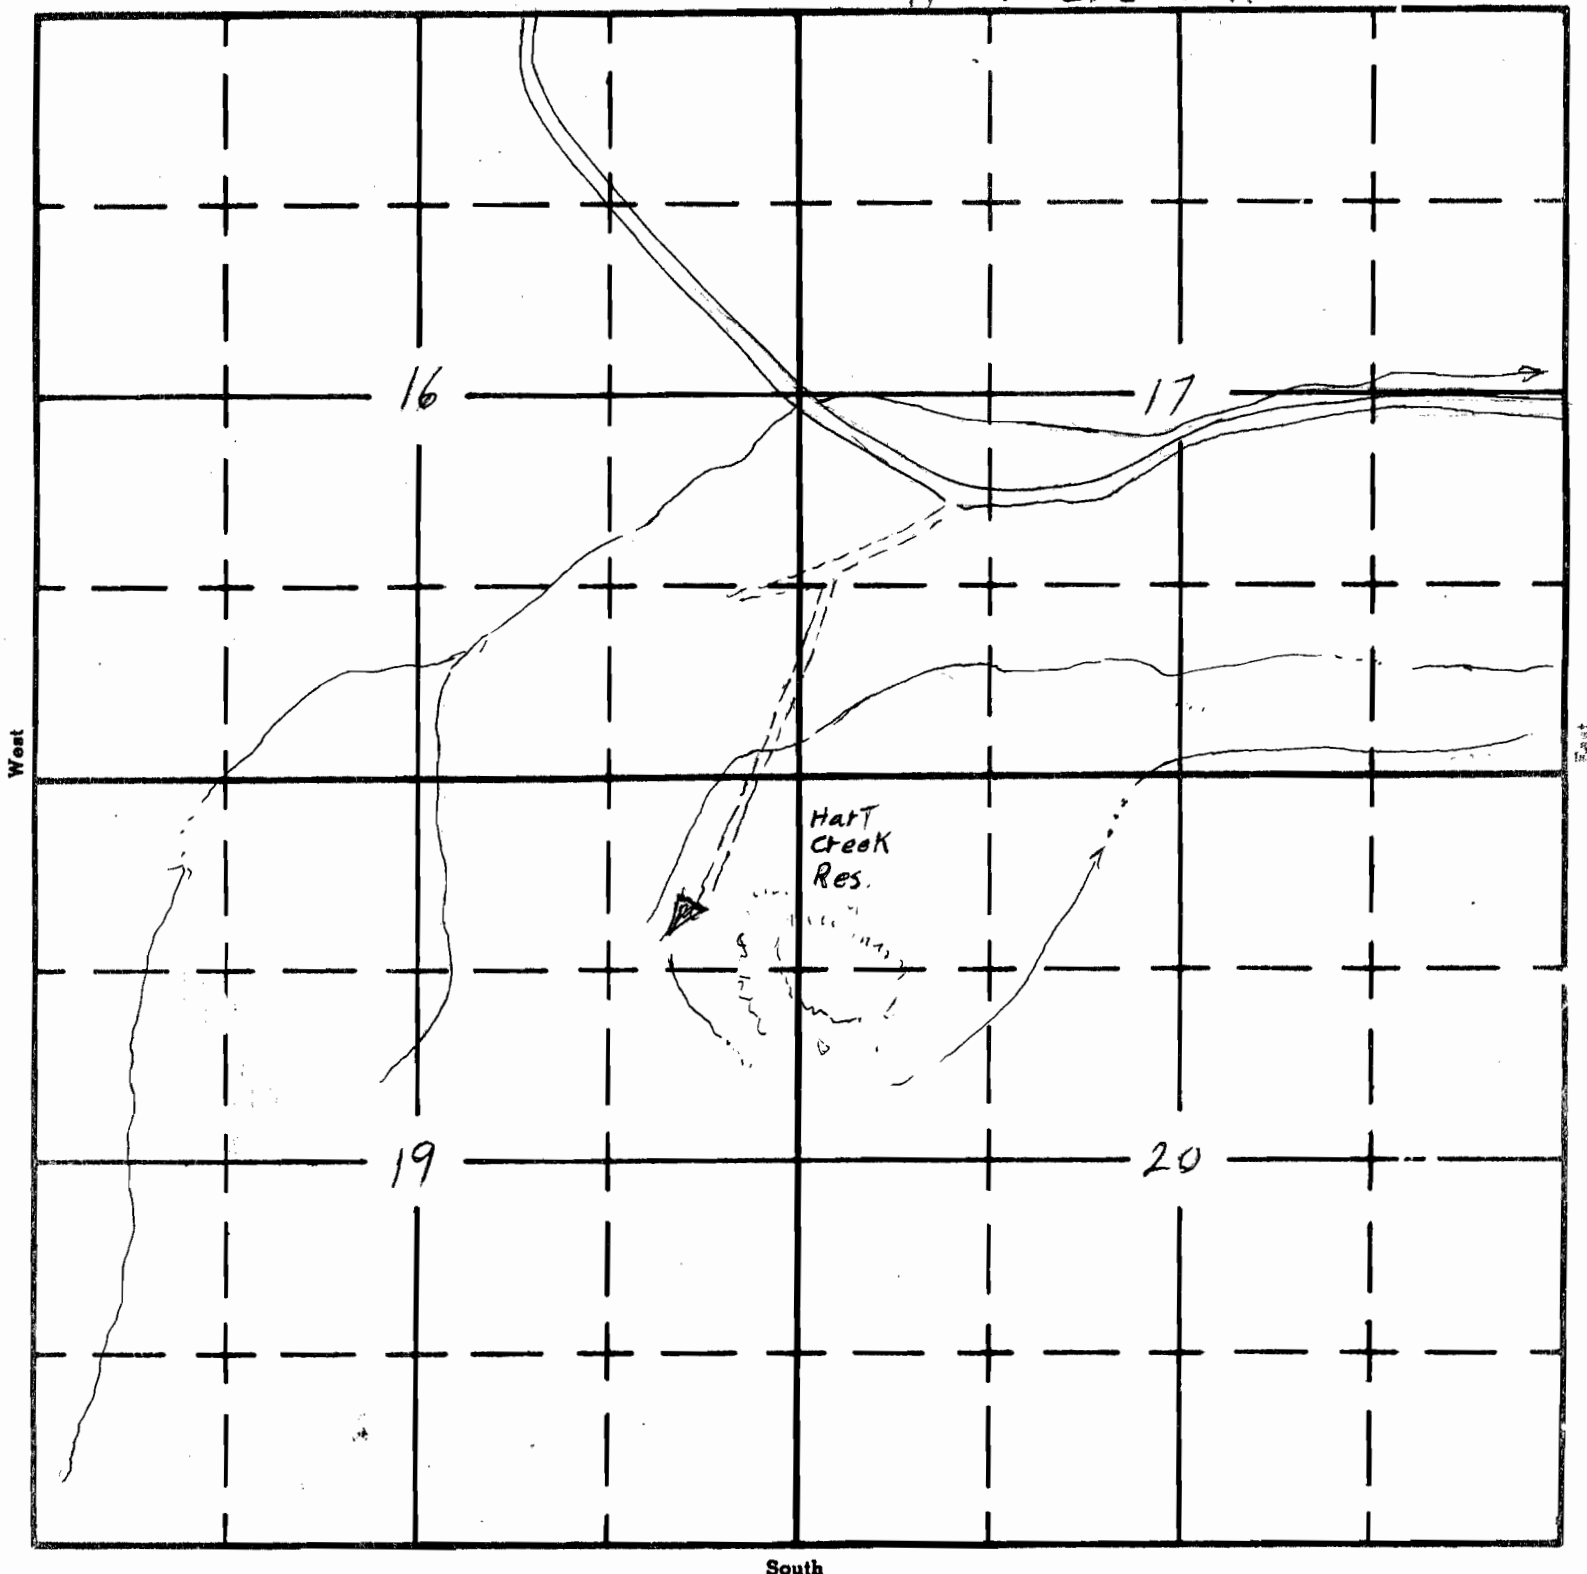

APPLICATION No. R-67803

PERMIT NO 10628