

UNITED STATES
DEPARTMENT OF THE INTERIOR
BUREAU OF LAND MANAGEMENT


SECTION

1 NWSW
Actually → SW SW

Oregon State Water Filings

TOWNSHIP 21 S, RANGE 44 E, W. M.

North DOUBLE MOUNTAIN

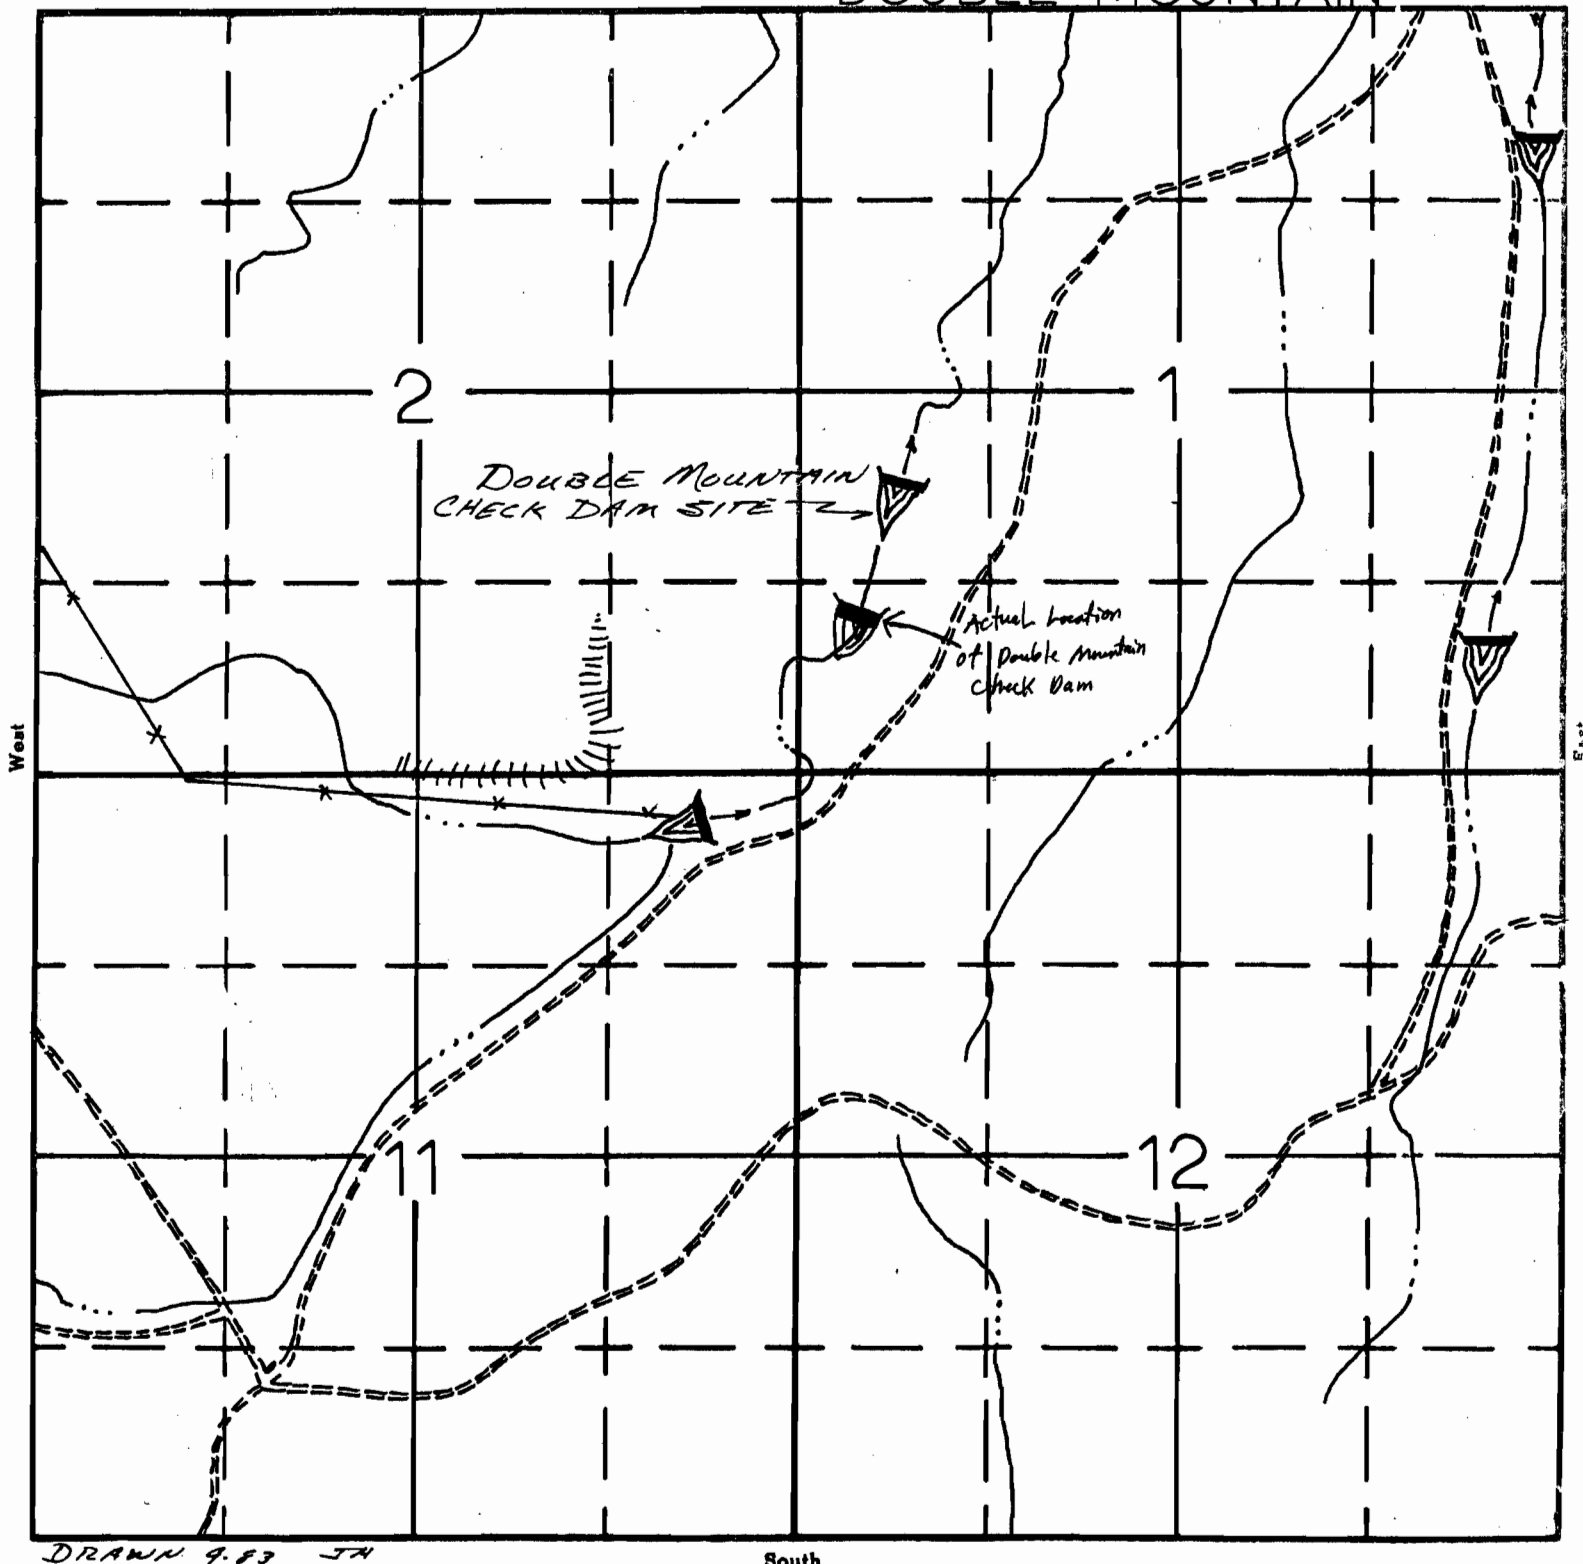

DRAWN 9.83 JH

South

APPLICATION No. P-67805
PERMIT No. B10630