

Form AI-187
March 1961

UNITED STATES
DEPARTMENT OF THE INTERIOR
BUREAU OF LAND MANAGEMENT


SECTION

Oregon State Water Filings

NE 1/4 SE 1/4 Sec. 9

TOWNSHIP 41-S, RANGE 26-E, W. M.

North

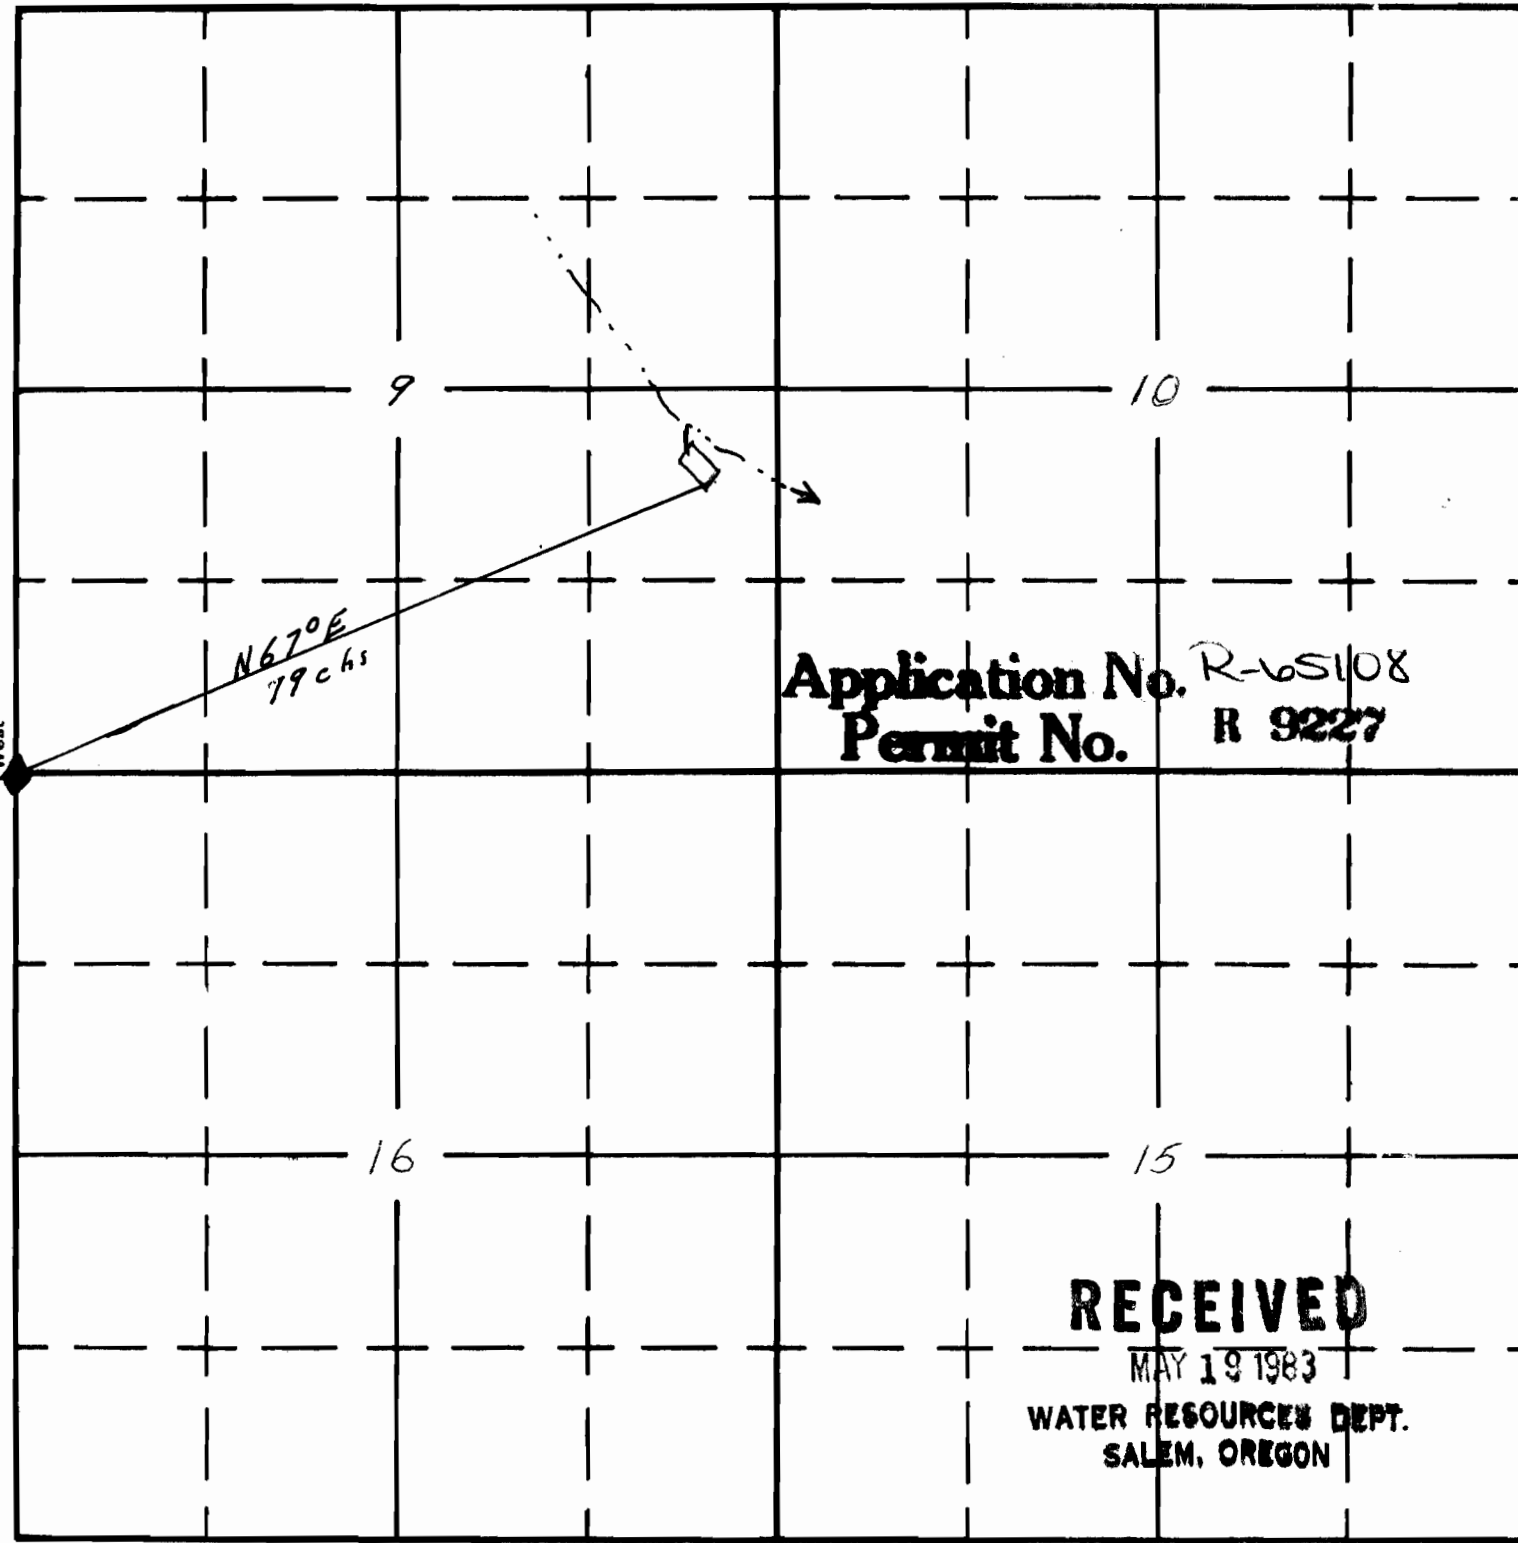

Application No. R-651108
Permit No. R 9227

RECEIVED
MAY 19 1983
WATER RESOURCES DEPT.
SALEM, OREGON