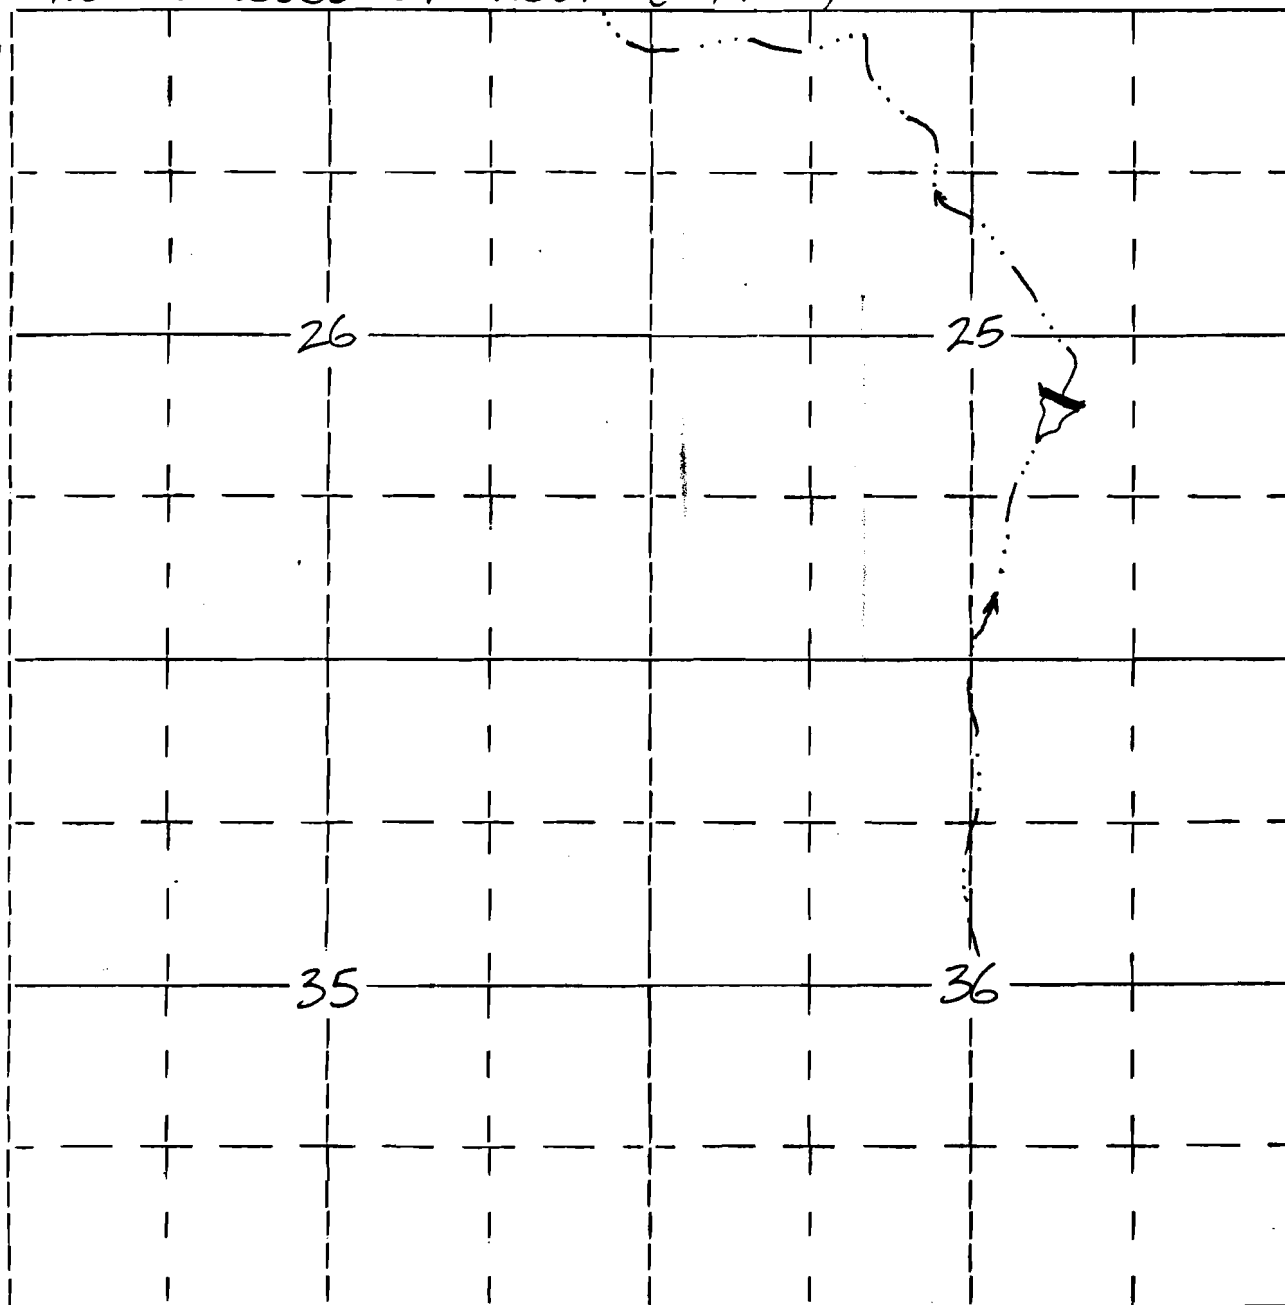


74593

Form OR-010-7300-2
4/83UNITED STATES
DEPARTMENT OF THE INTERIOR
BUREAU OF LAND MANAGEMENTSection
25NWSETownship 40 southRange 25 eastAppl. No. R-66296Permit No. R10580

Will. Mer.

North Rosebriar Res. (#4409)

1980' N., 2110' W. of SE corner of section 25