

Form A1-187
March 1961

UNITED STATES
DEPARTMENT OF THE INTERIOR
BUREAU OF LAND MANAGEMENT

RECEIVED

SEP 30 1983


SECTION 20
NWSE

Oregon State Water Filings

WATER RESOURCES DEPT
SALEM, OREGON

TOWNSHIP 17 S, RANGE 40 E, W. M.

NORTH ~~BULLY~~ #1

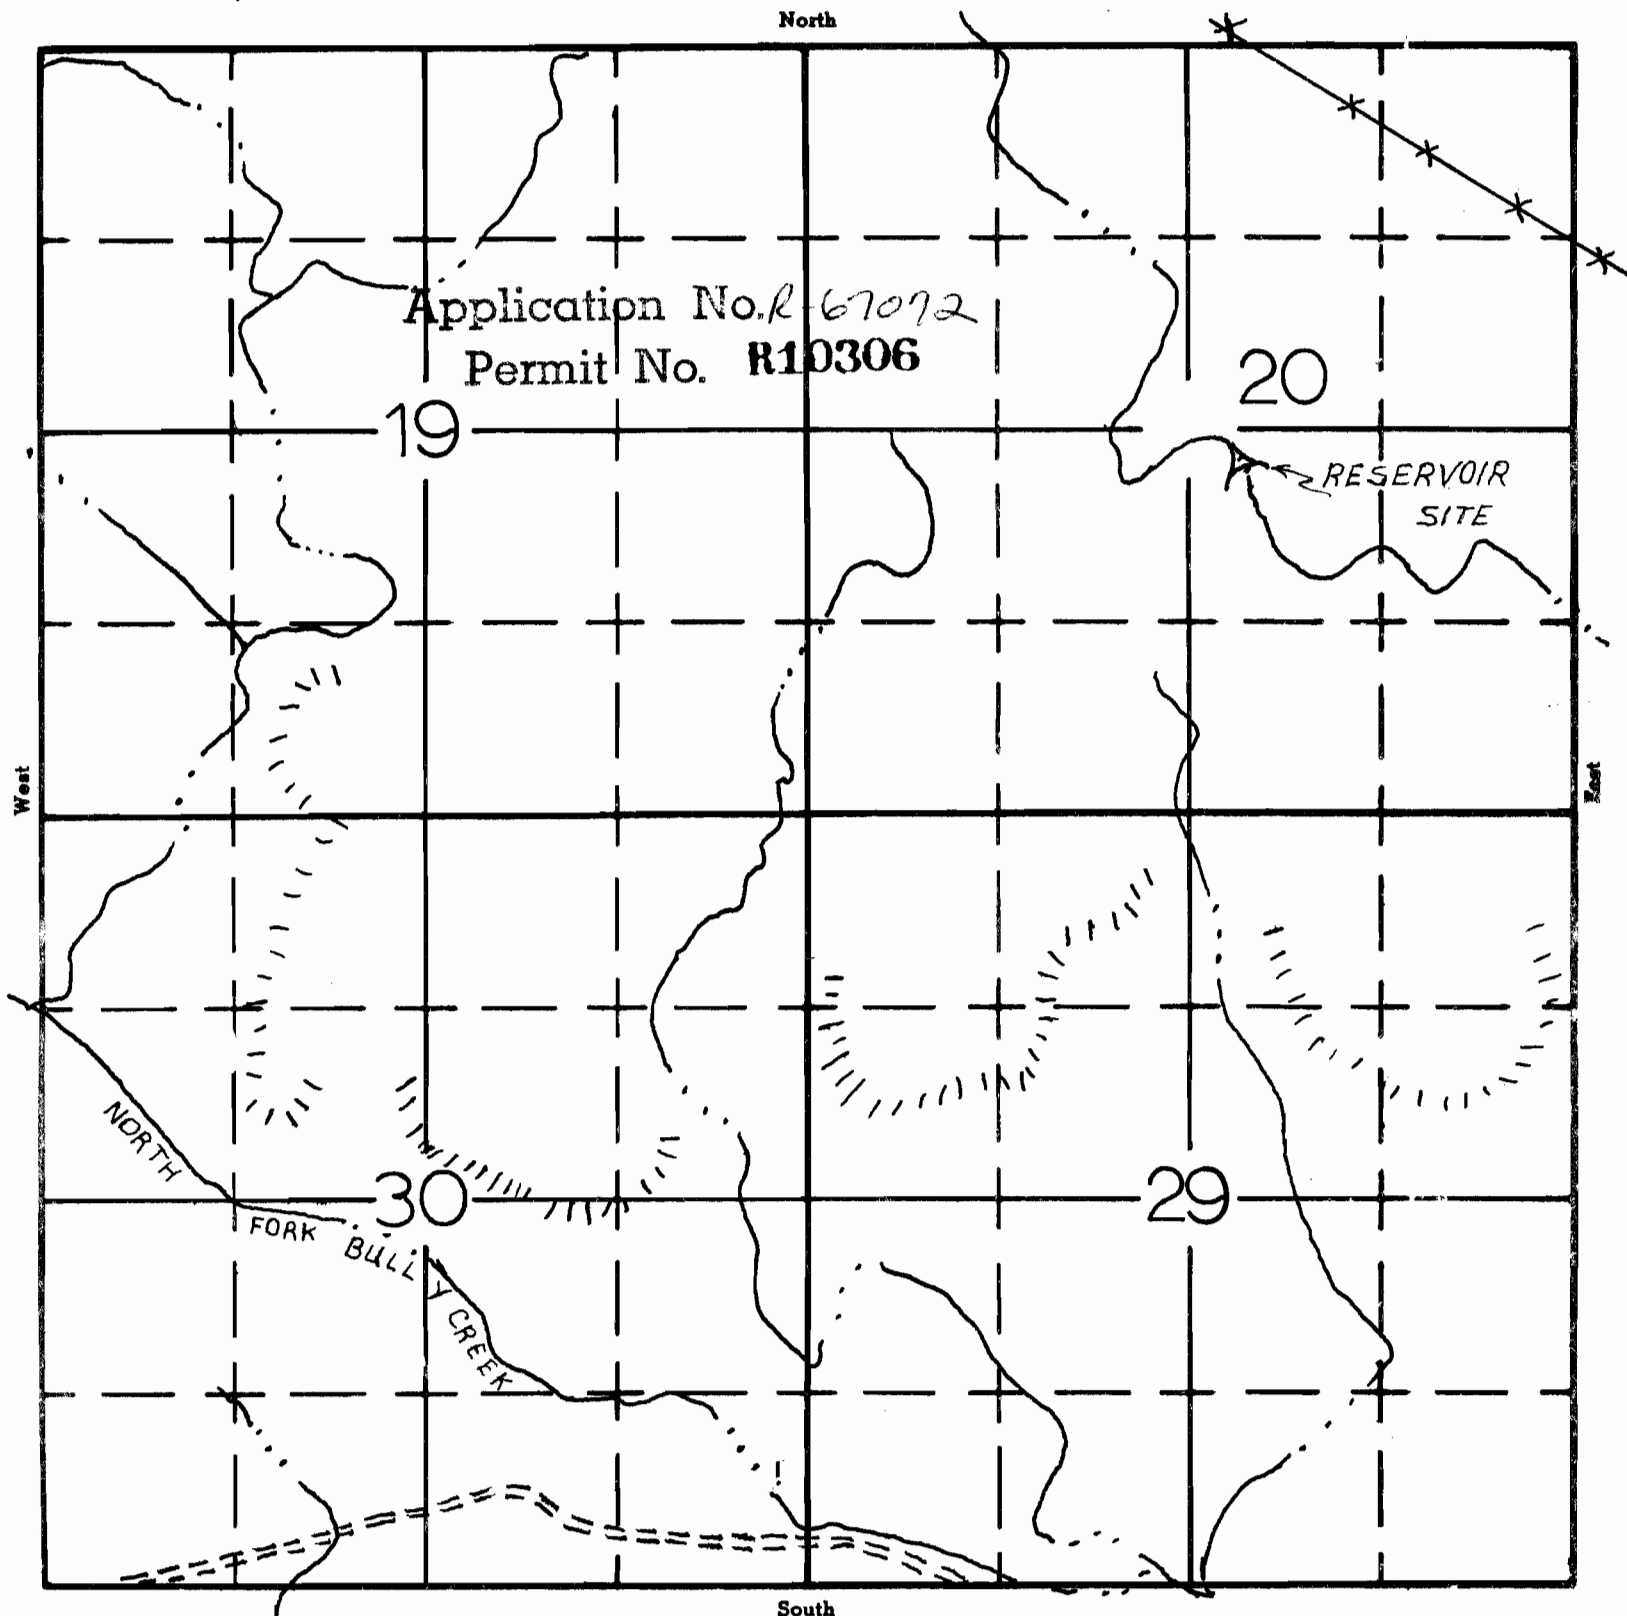

Application No. R-67092
Permit No. R10306

20

RESERVOIR
SITE

19

30

29

NORTH
FORK
BULLY CREEK

APPLICATION No.
PERMIT No.