

Form AI-187
March 1961

UNITED STATES
DEPARTMENT OF THE INTERIOR
BUREAU OF LAND MANAGEMENT


SECTION 11

Oregon State Water Filings

SWNW

TOWNSHIP 19 S., RANGE 45 E., W. M.

LOCKET RES.

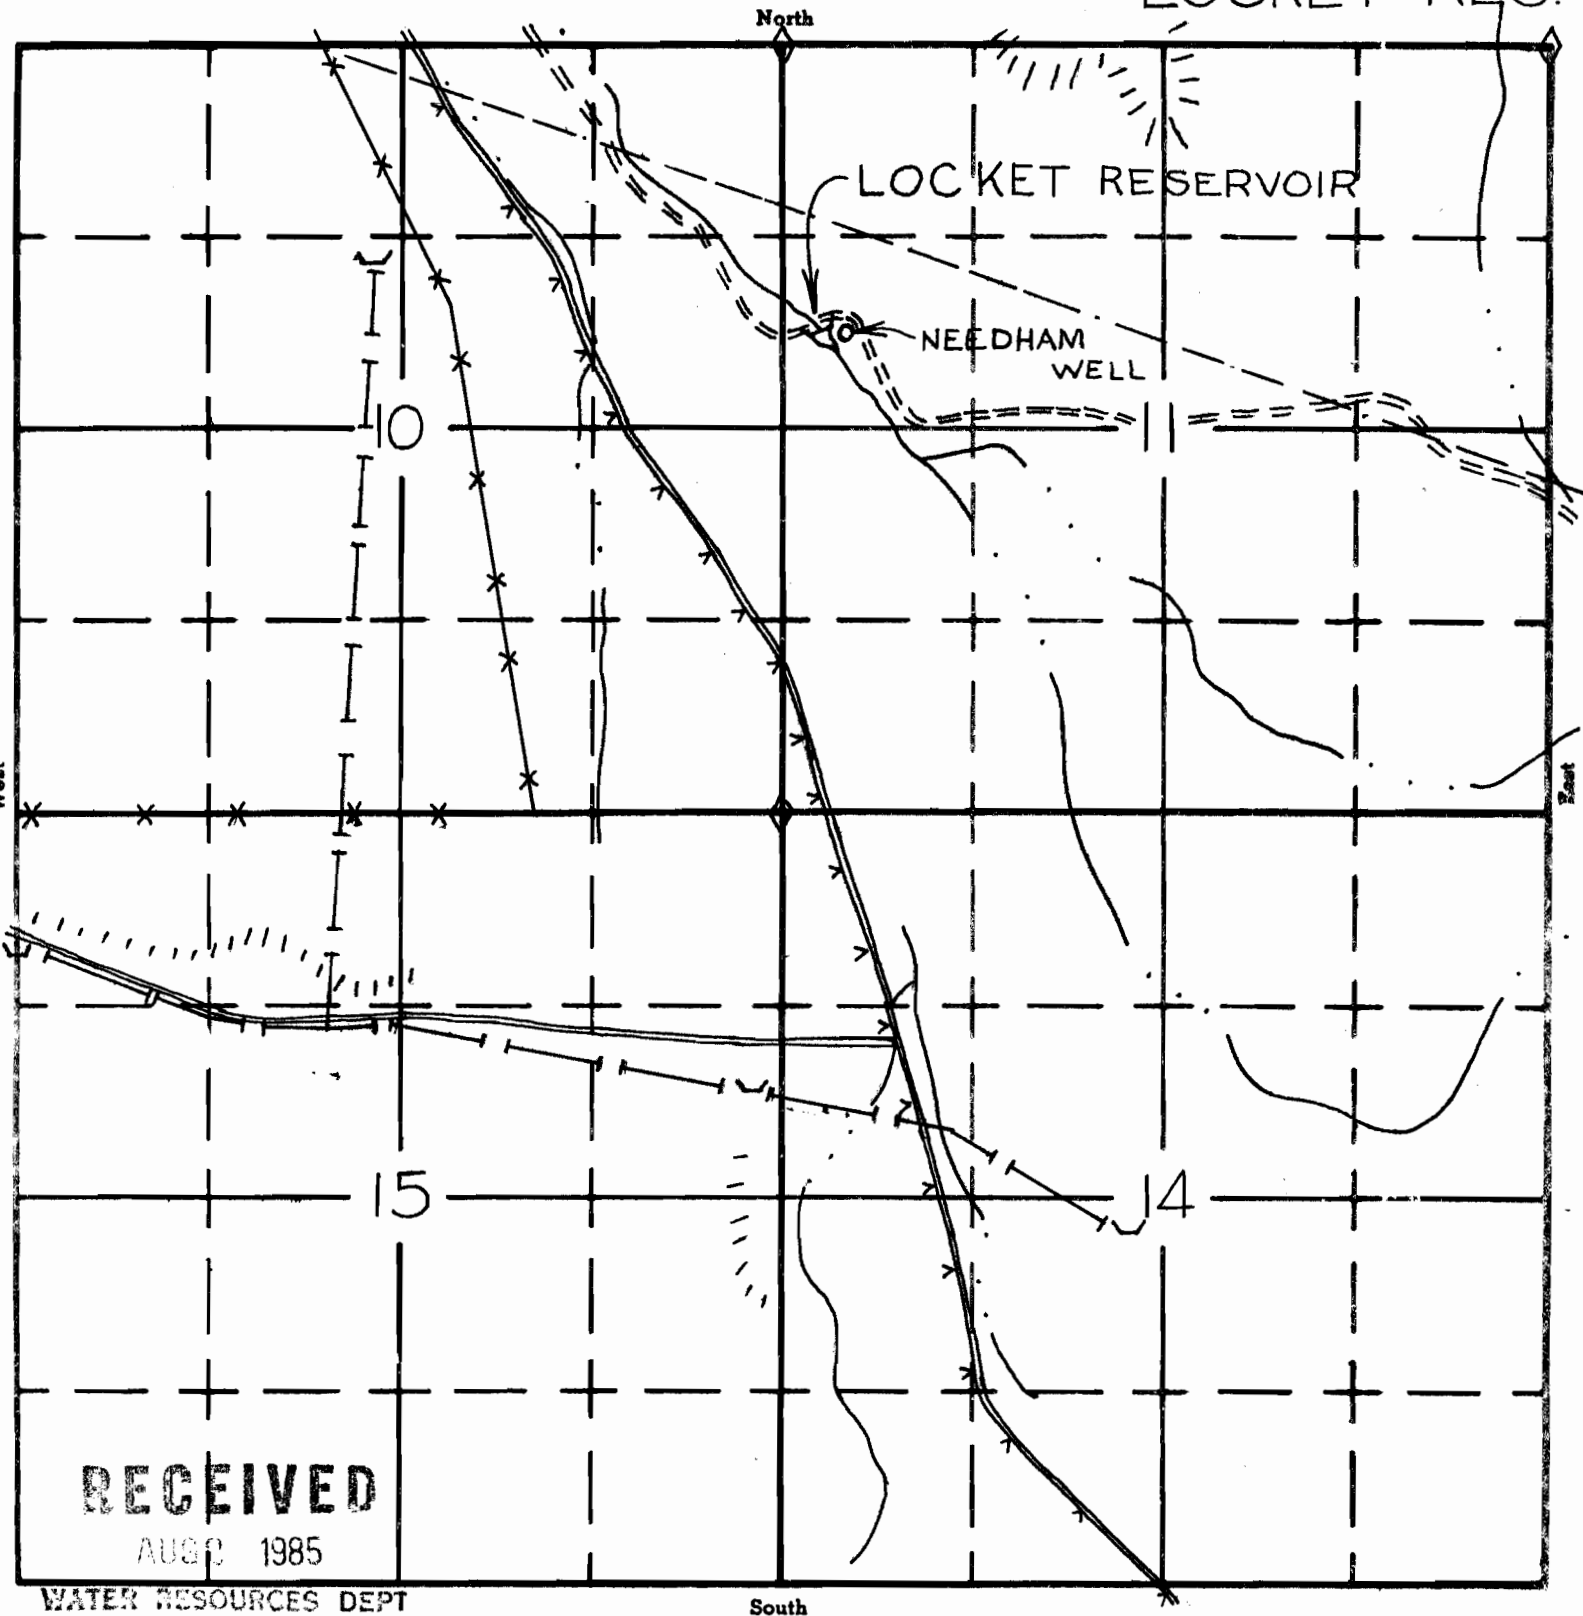

RECEIVED
AUG 2 1985

WATER RESOURCES DEPT
SALEM, OREGON

APPLICATION No. R-67080
PERMIT No. R10524