

UNITED STATES  
DEPARTMENT OF THE INTERIOR  
BUREAU OF LAND MANAGEMENT


R 2434  
74611

SECTION


TOWNSHIP 28S, RANGE 13E, W. M.

North

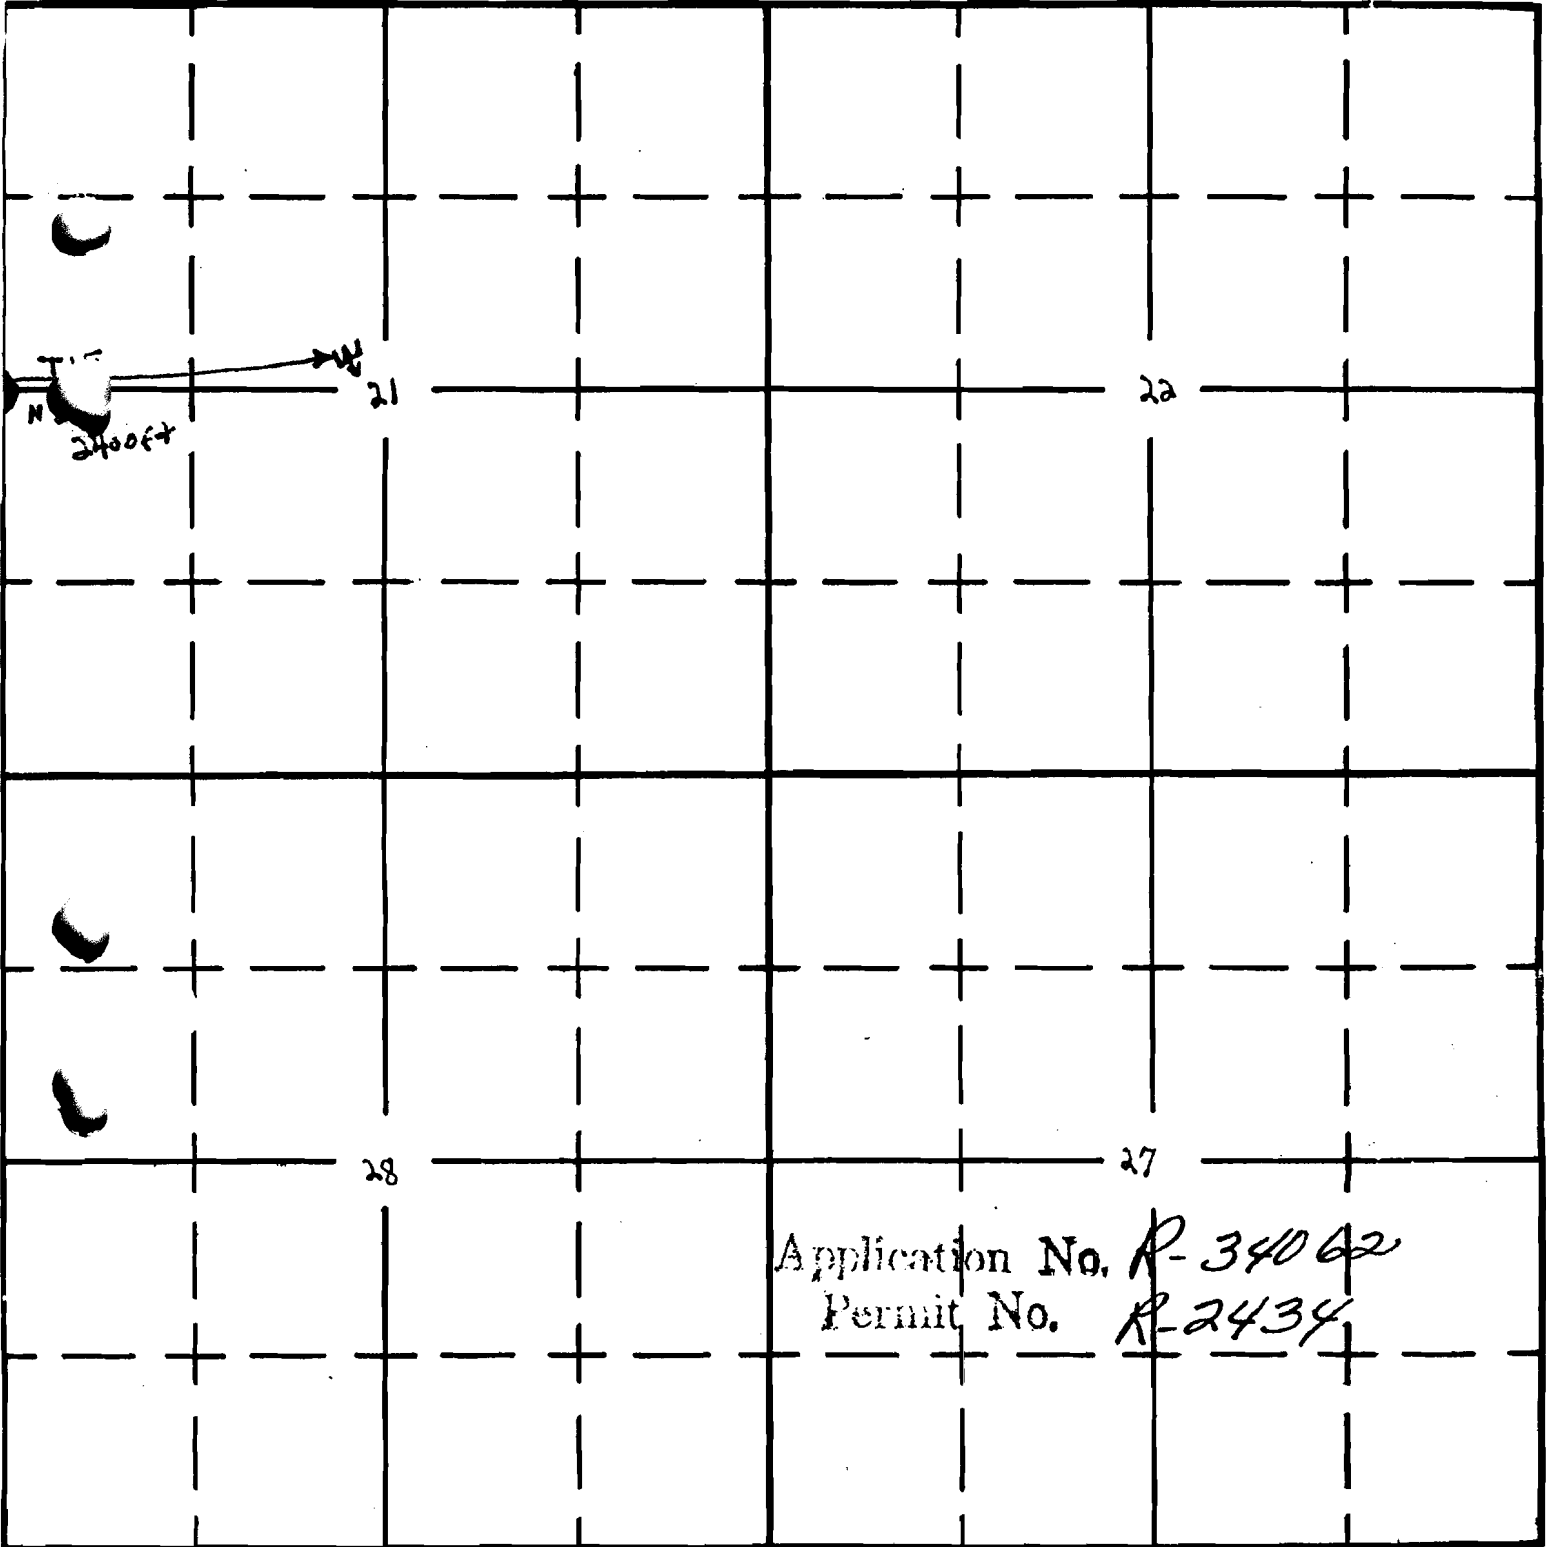

East

Application No. R-34062  
Permit No. R-2434

◆ FOUND SURVEY CORNER  
W PROJECT

South

APPLICATION No.  
PERMIT No.