

UNITED STATES
DEPARTMENT OF THE INTERIOR
BUREAU OF LAND MANAGEMENT


R2428
74612

SECTION

Oregon State Water Filings

TOWNSHIP 21 S, RANGE 13 E, W. M.

North

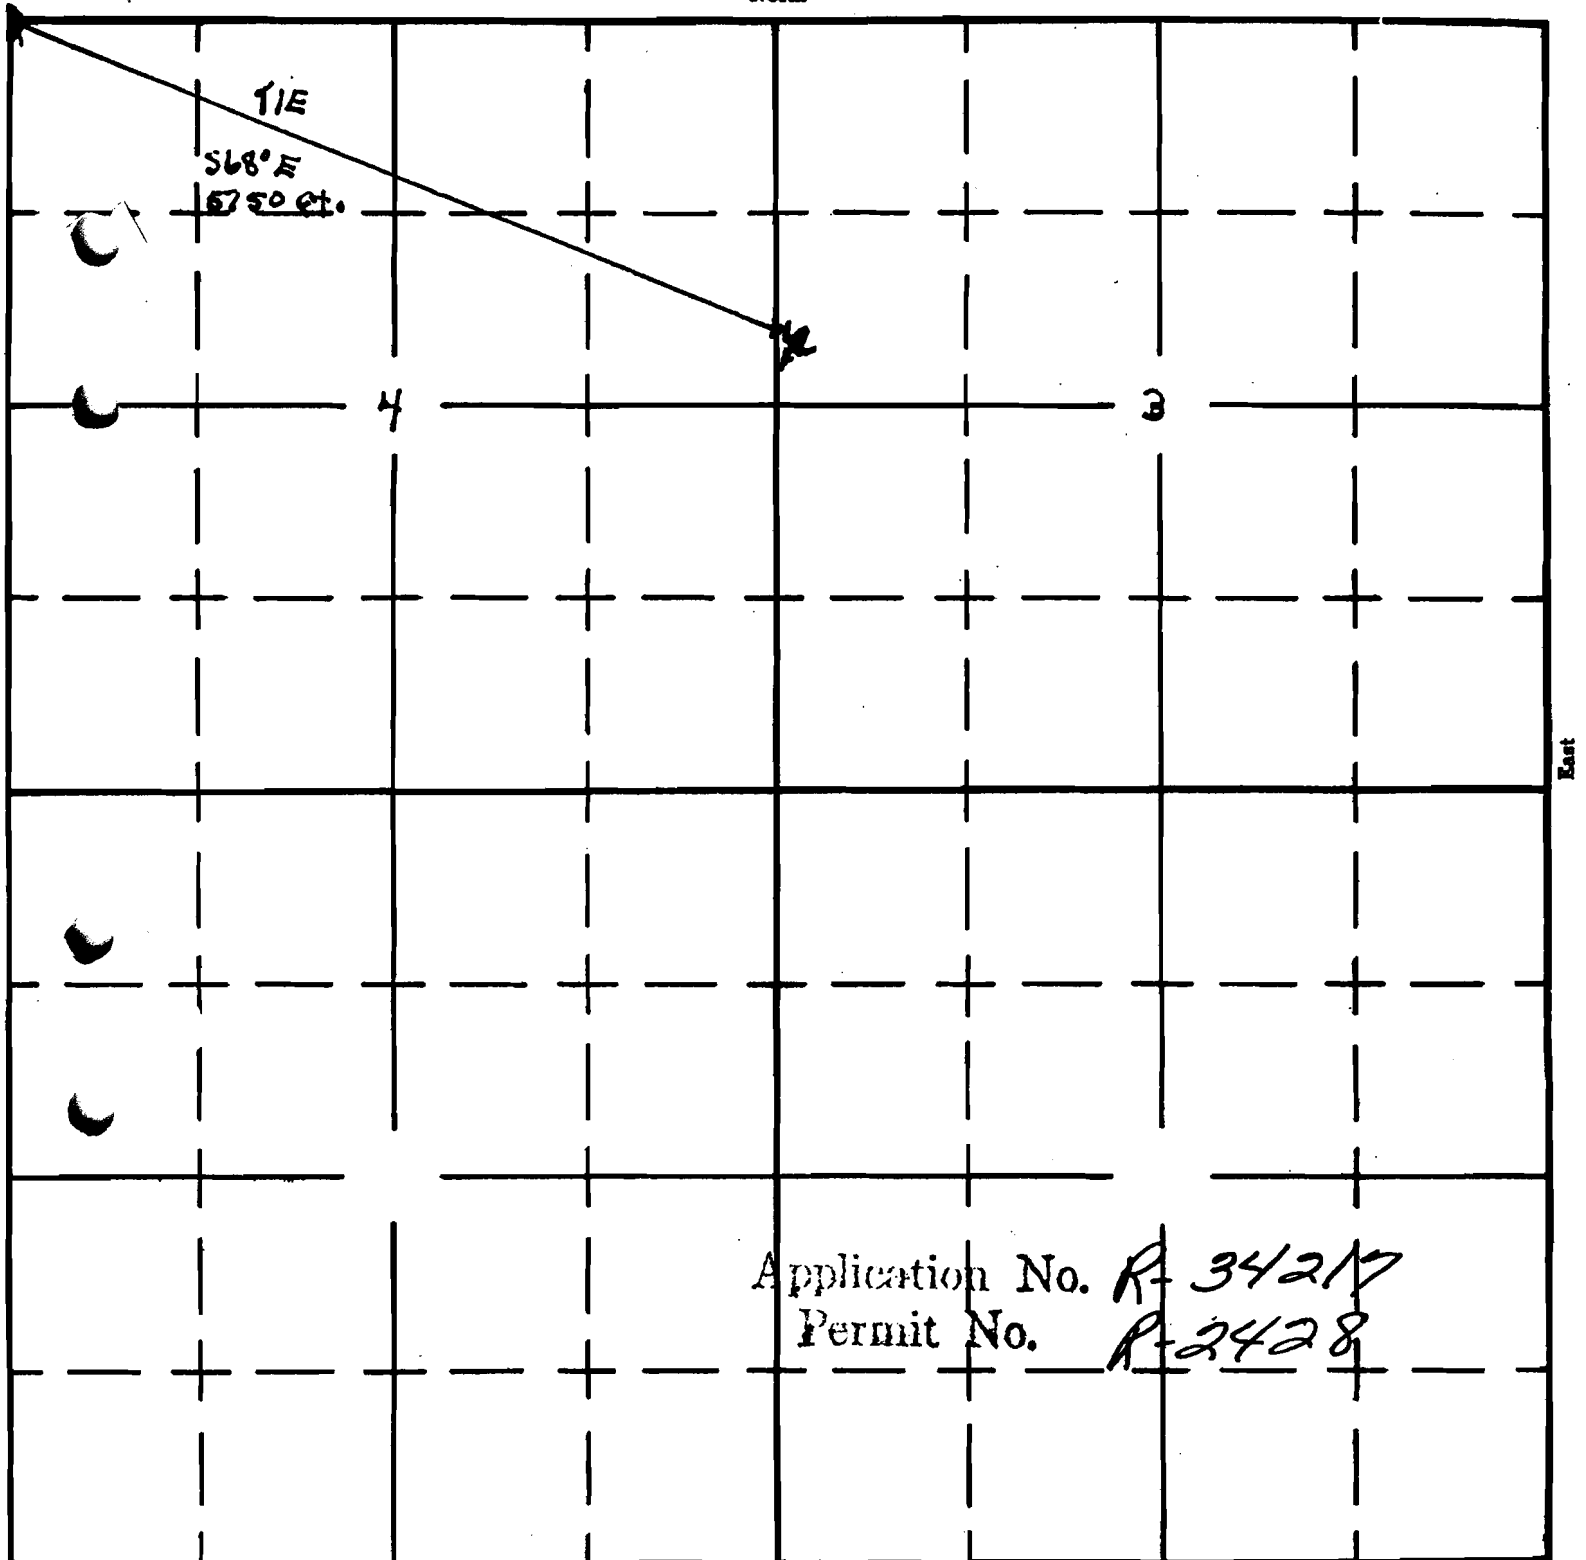

East

South

APPLICATION No.
PERMIT No.