

UNITED STATES
DEPARTMENT OF THE INTERIOR
BUREAU OF LAND MANAGEMENT

R-2539.

74613


75505

SECTION

Oregon State Water Filings

TOWNSHIP 29S, RANGE 16E, W. M.

North COTTONWOOD SPRING RESERVOIR

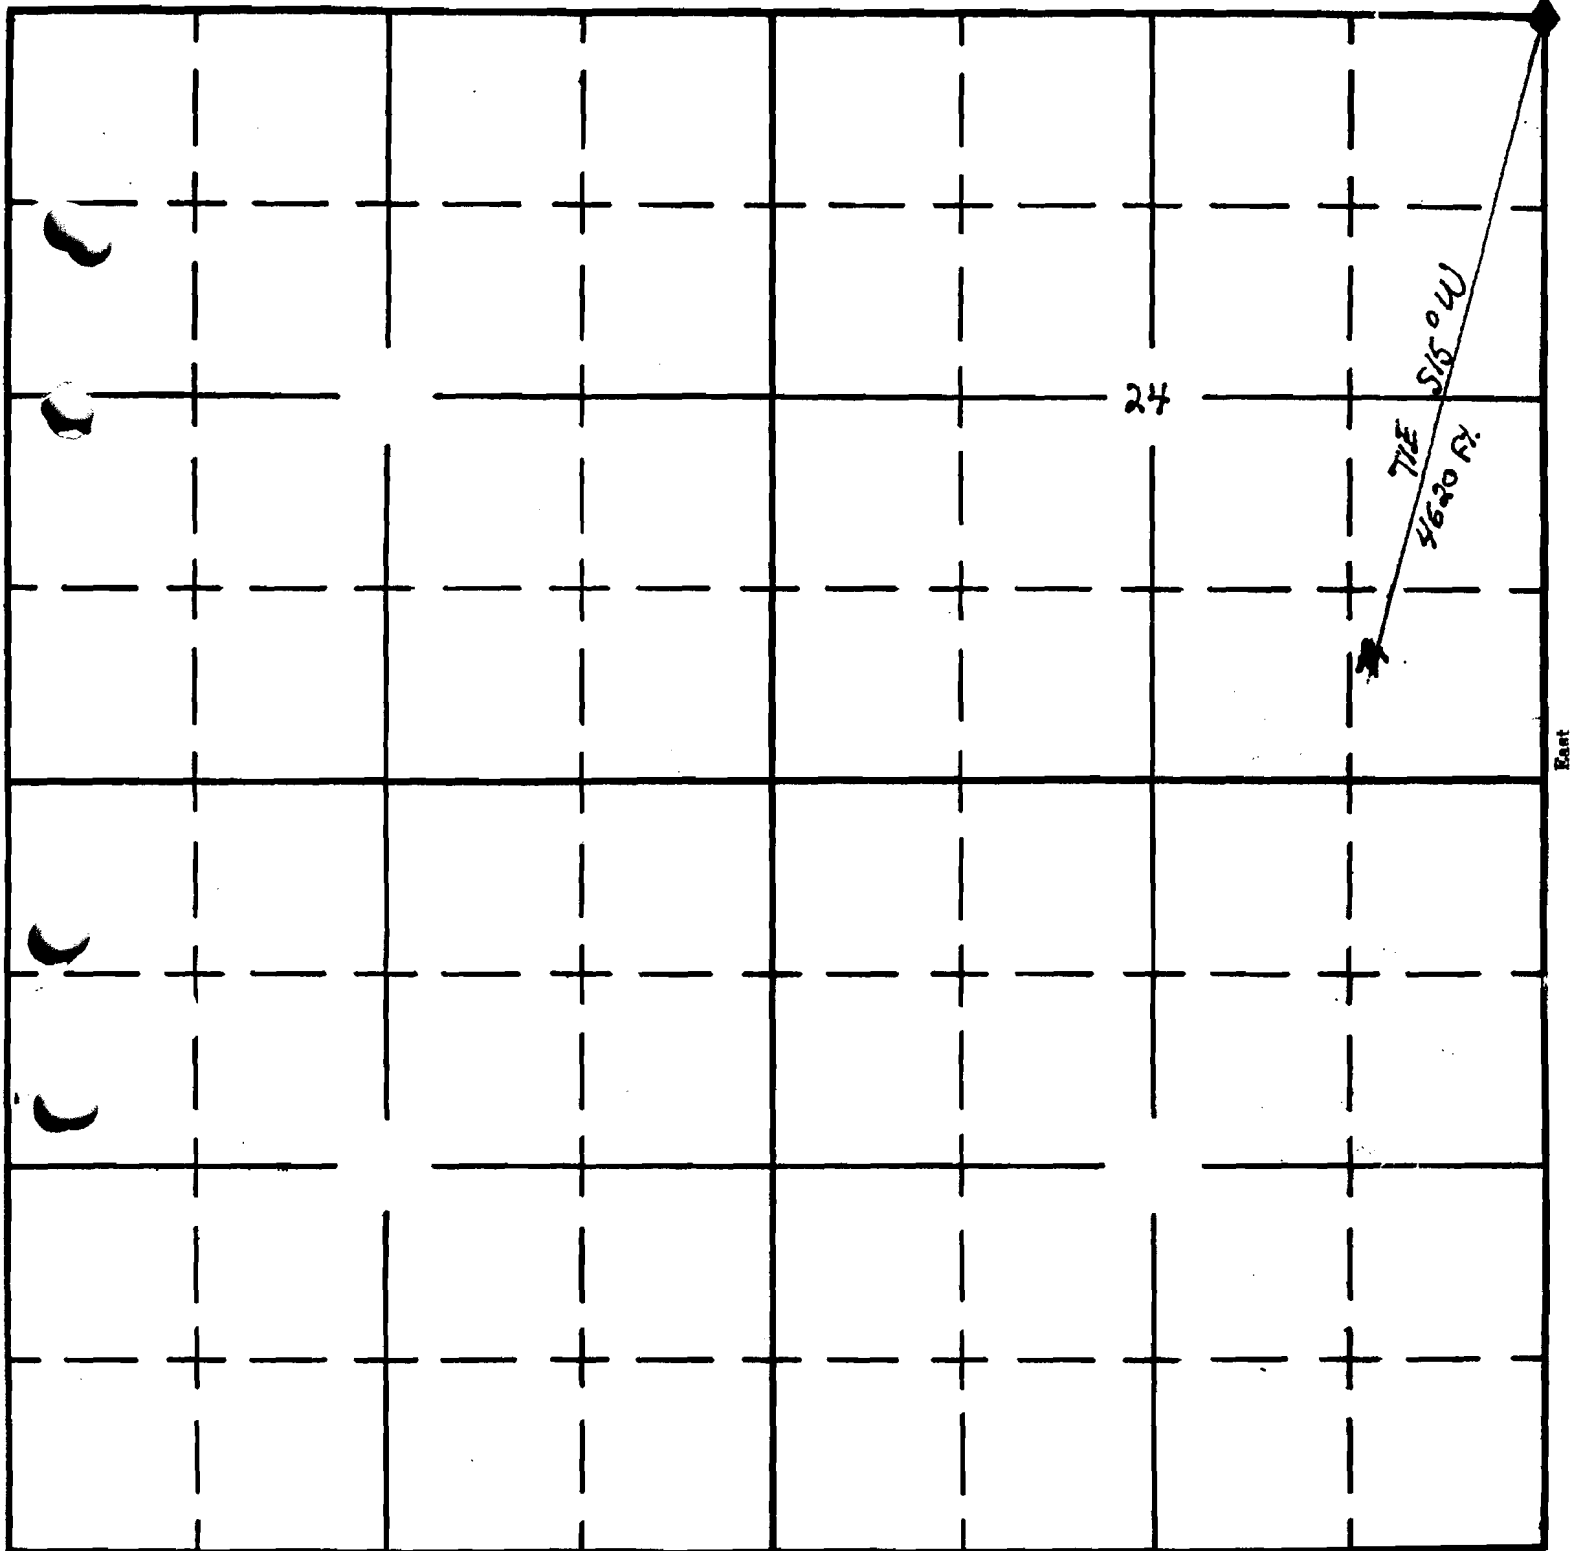

◆ FOUND SURVEY CORNER

South

W PROJECT

APPLICATION No. R-34362

PERMIT No. R-2539