

Form AI-187
March 1961

UNITED STATES
DEPARTMENT OF THE INTERIOR
BUREAU OF LAND MANAGEMENT

SECTION


29

Oregon State Water Filings

SE 1/4 SE 1/4

TOWNSHIP 28 S, RANGE 17 E, W. M.

North

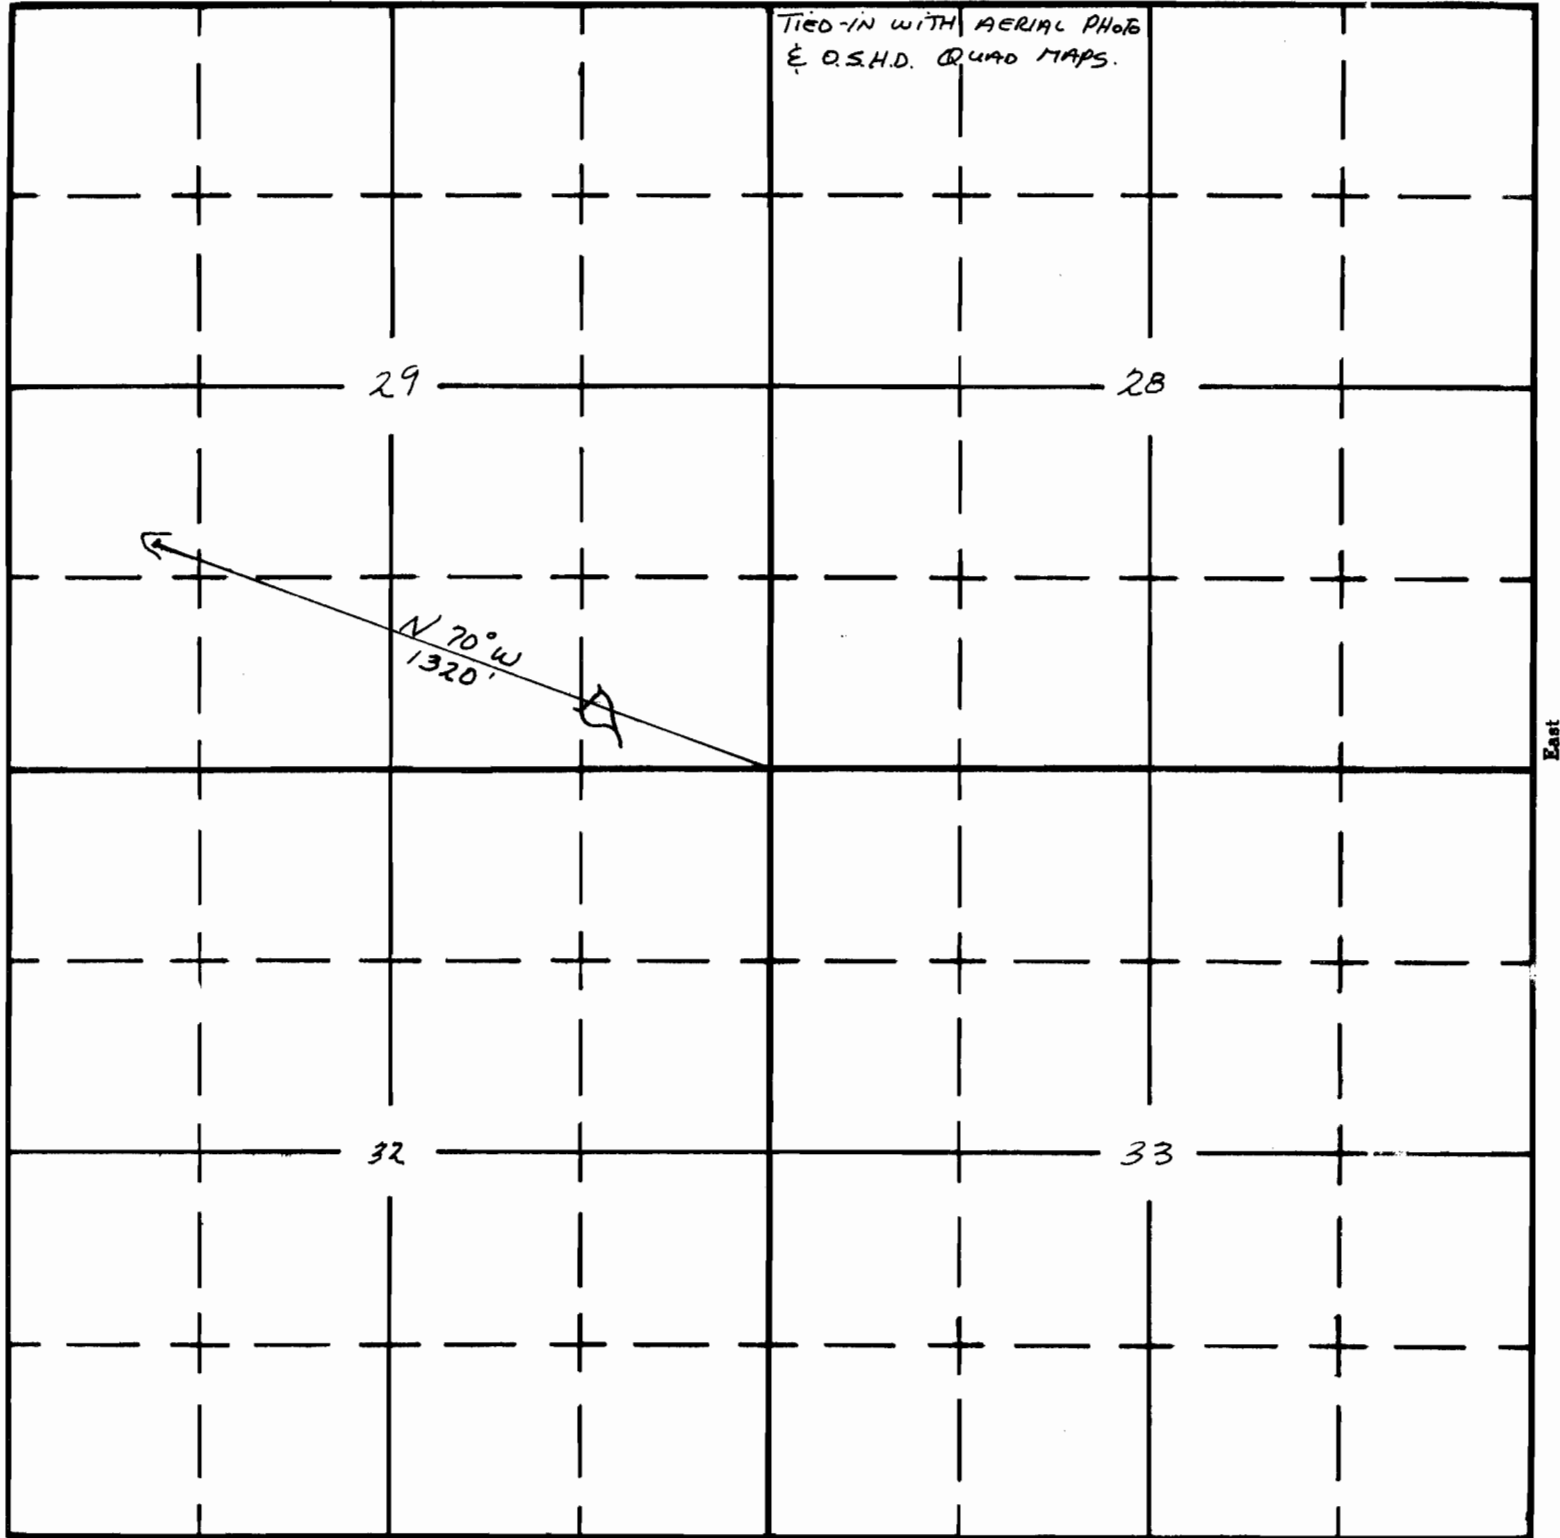

South

APPLICATION No. R-35145
PERMIT No. R-2852