

UNITED STATES
DEPARTMENT OF THE INTERIOR
BUREAU OF LAND MANAGEMENT

SECTION


29

Oregon State Water Filings

NE 1/4 NW 1/4

TOWNSHIP 28 S, RANGE 17 E, W. M.

North

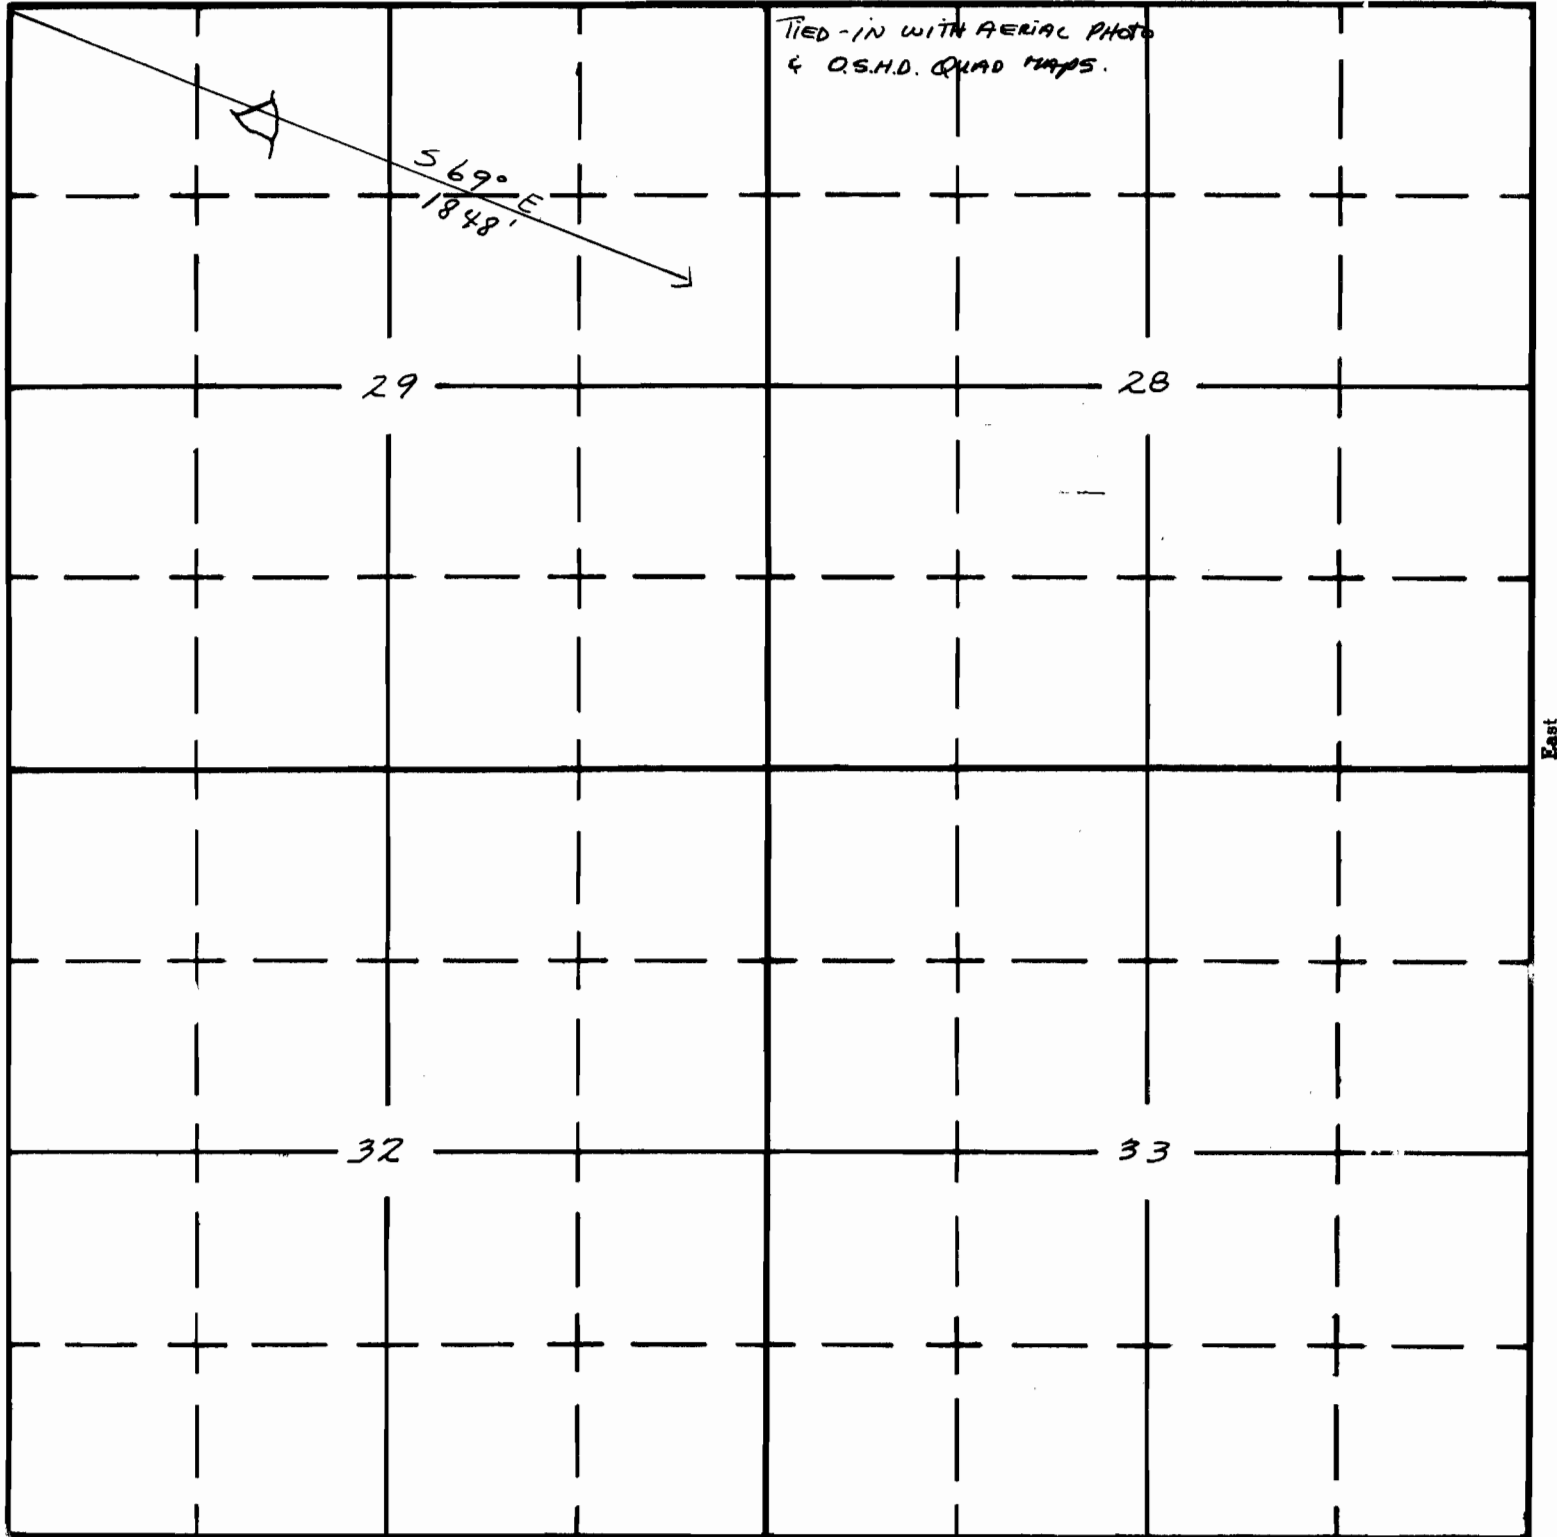

South

APPLICATION No. R-35147
PERMIT No. R-2853