

UNITED STATES
DEPARTMENT OF THE INTERIOR
BUREAU OF LAND MANAGEMENT


SECTION 6

Oregon State Water Filings

SE 1/4 NW 1/4

TOWNSHIP 29S, RANGE 18E, W. M.

North

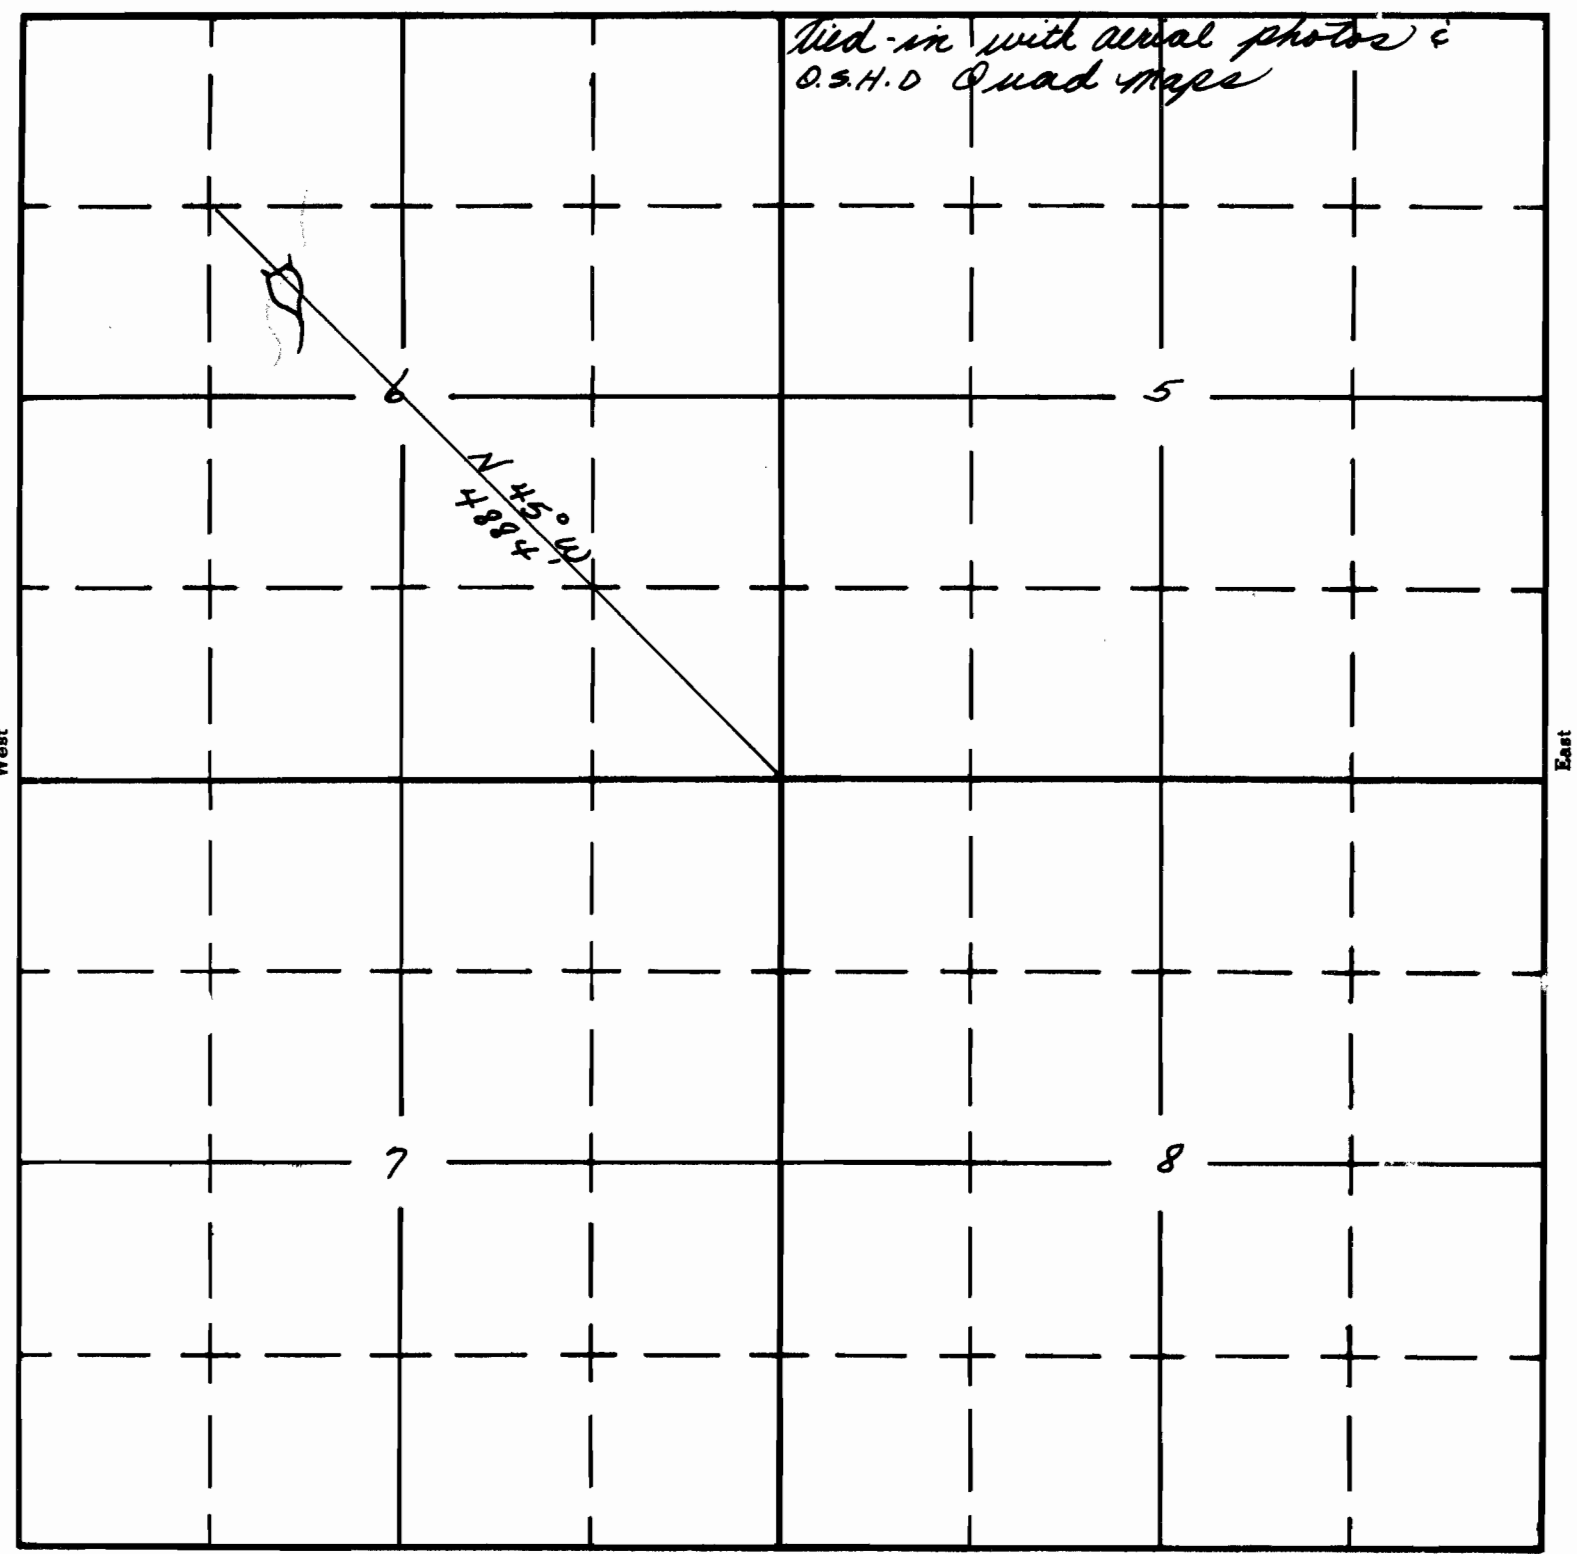

South