

Form AI-187
March 1961

UNITED STATES
DEPARTMENT OF THE INTERIOR
BUREAU OF LAND MANAGEMENT


SECTION

NE 1/4 SE 1/4 Oregon State Water Filings

18

TOWNSHIP 39 S, RANGE 32 E, W. M.

North

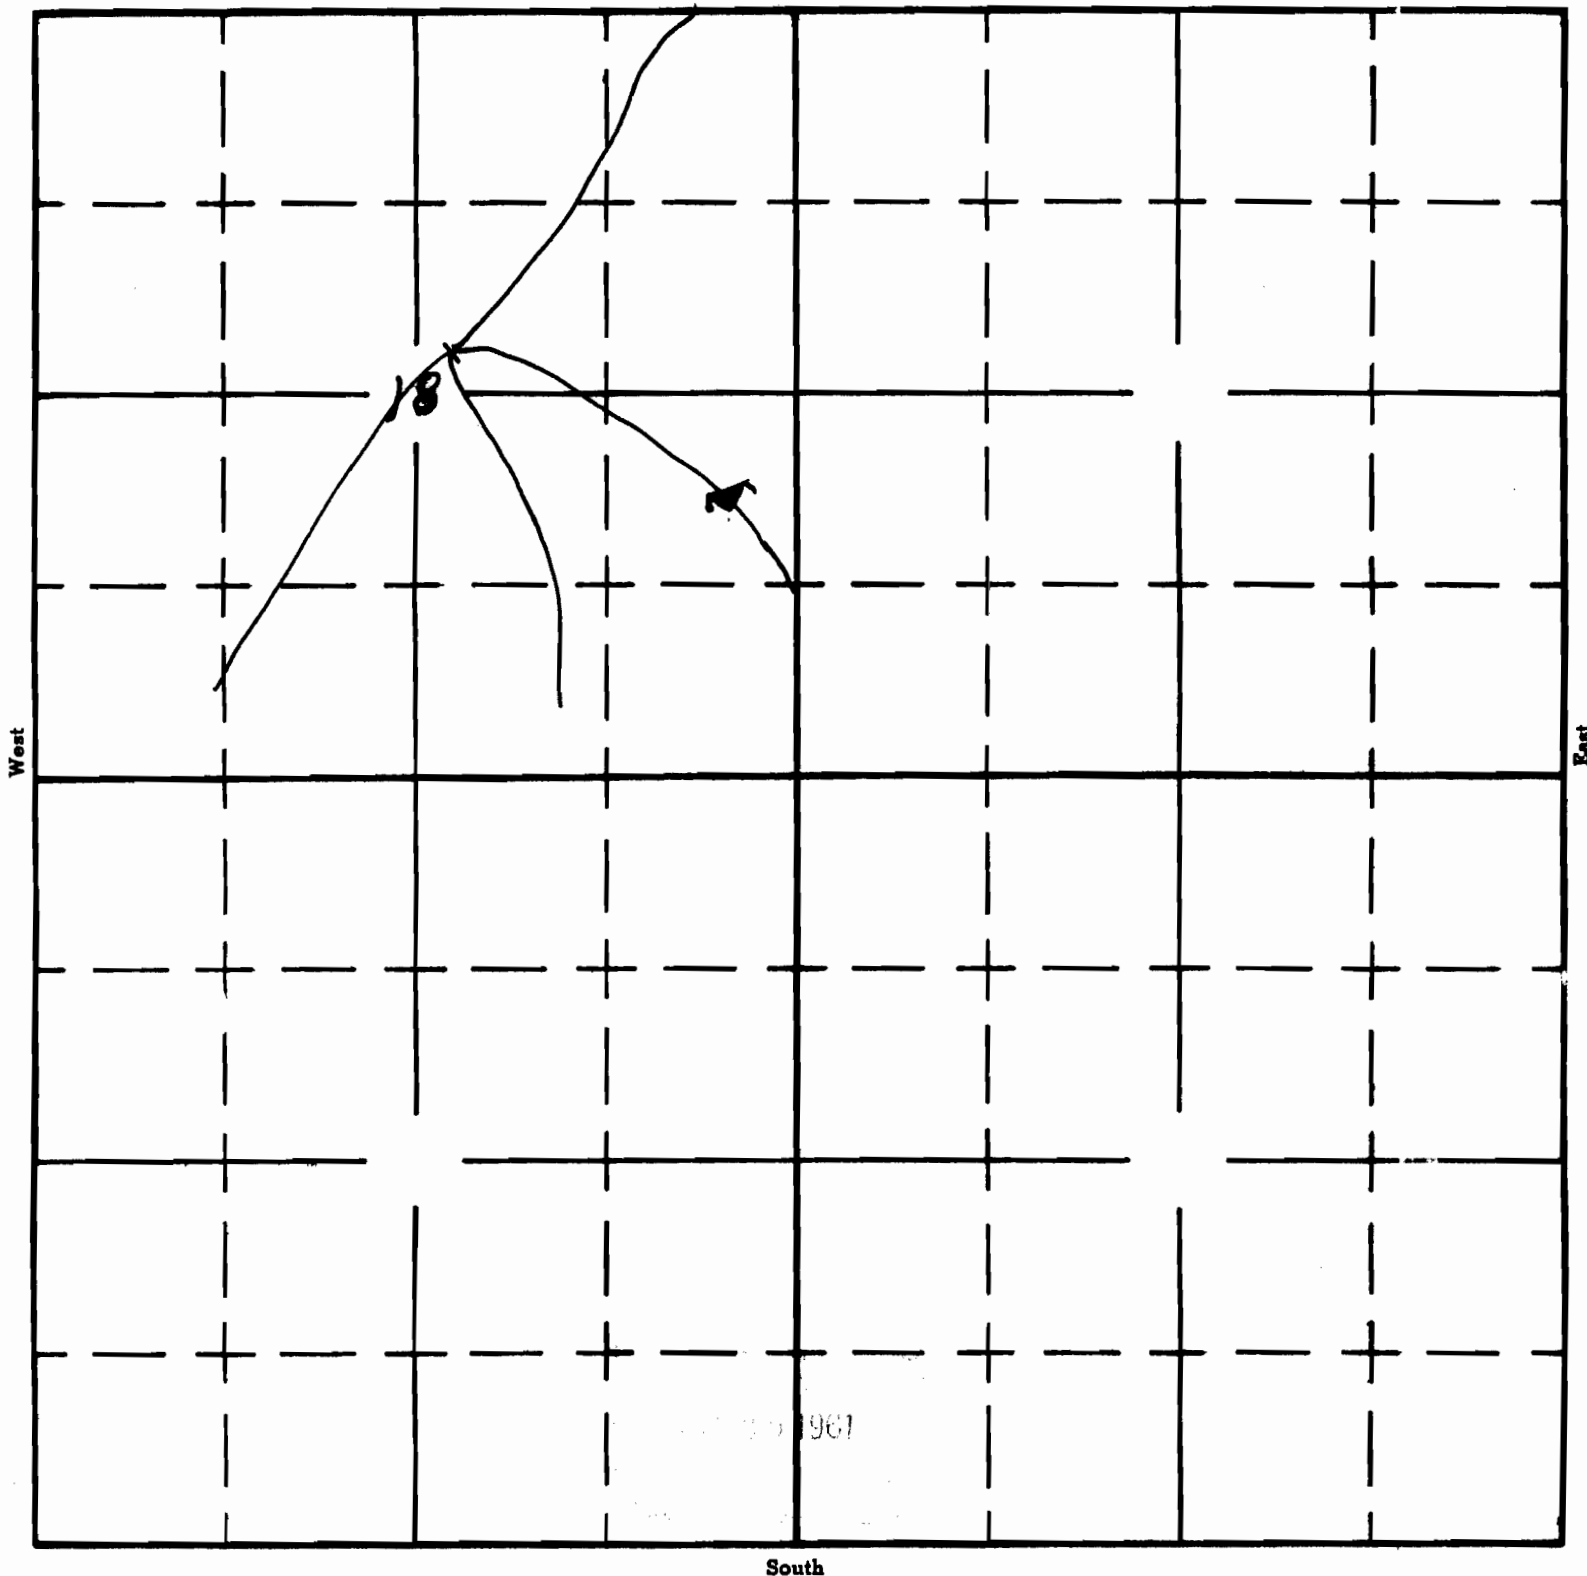

South

APPLICATION No. R-35512
PERMIT No. R-4008