

UNITED STATES
DEPARTMENT OF THE INTERIOR
BUREAU OF LAND MANAGEMENT

SECTION


SE 1/4 SW 1/4

Oregon State Water Filings

16

TOWNSHIP 39S, RANGE 38E, W. M.

North

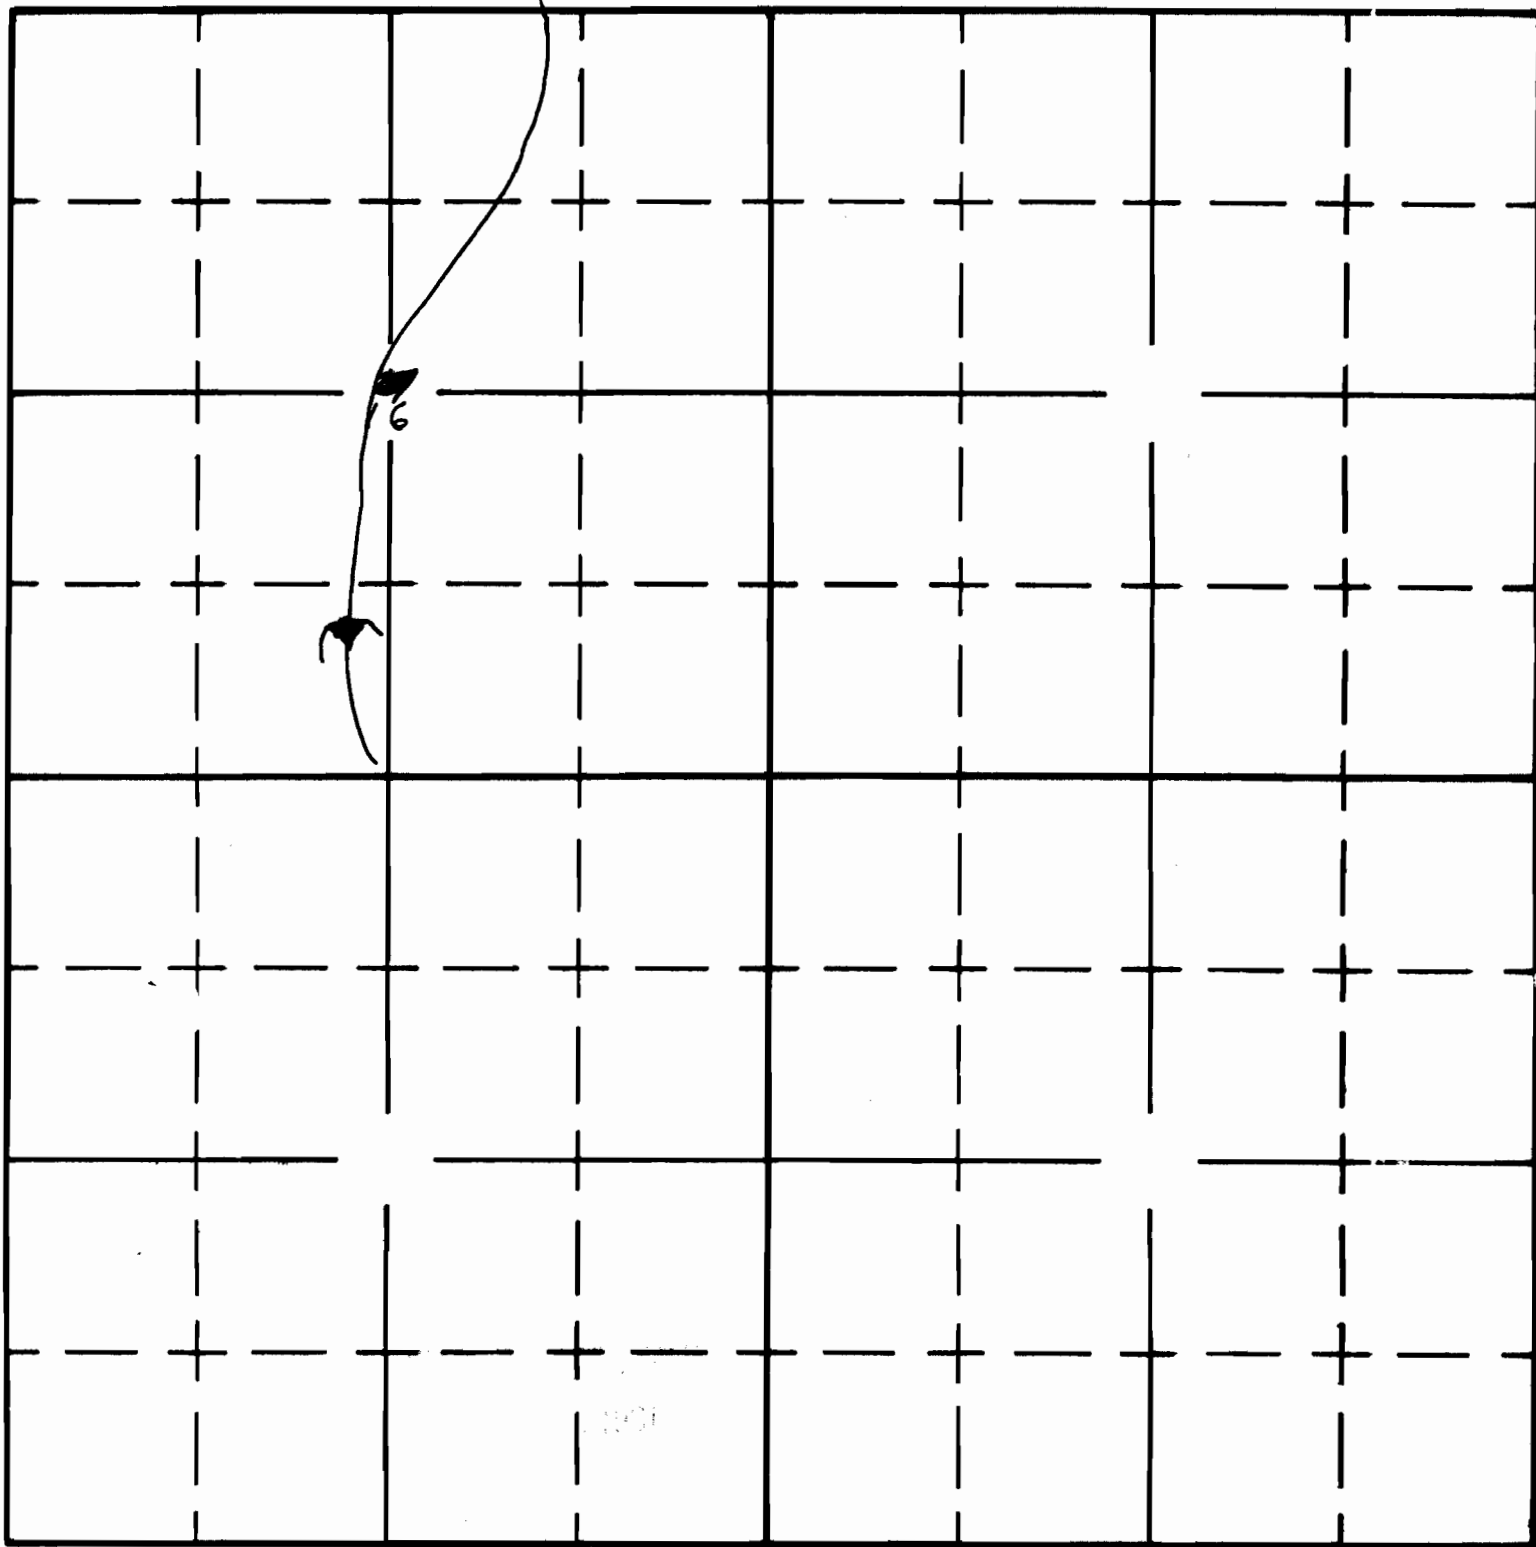

South

APPLICATION No. R-35613

PERMIT No. R-4009