

Form AI-187
March 1961

UNITED STATES
DEPARTMENT OF THE INTERIOR
BUREAU OF LAND MANAGEMENT

SECTION


5

Oregon State Water Filings

SW $\frac{1}{4}$ SW $\frac{1}{4}$

TOWNSHIP 31S, RANGE 28E, W. M.

North Tied in with aerial Photo and OSHO Quad maps.

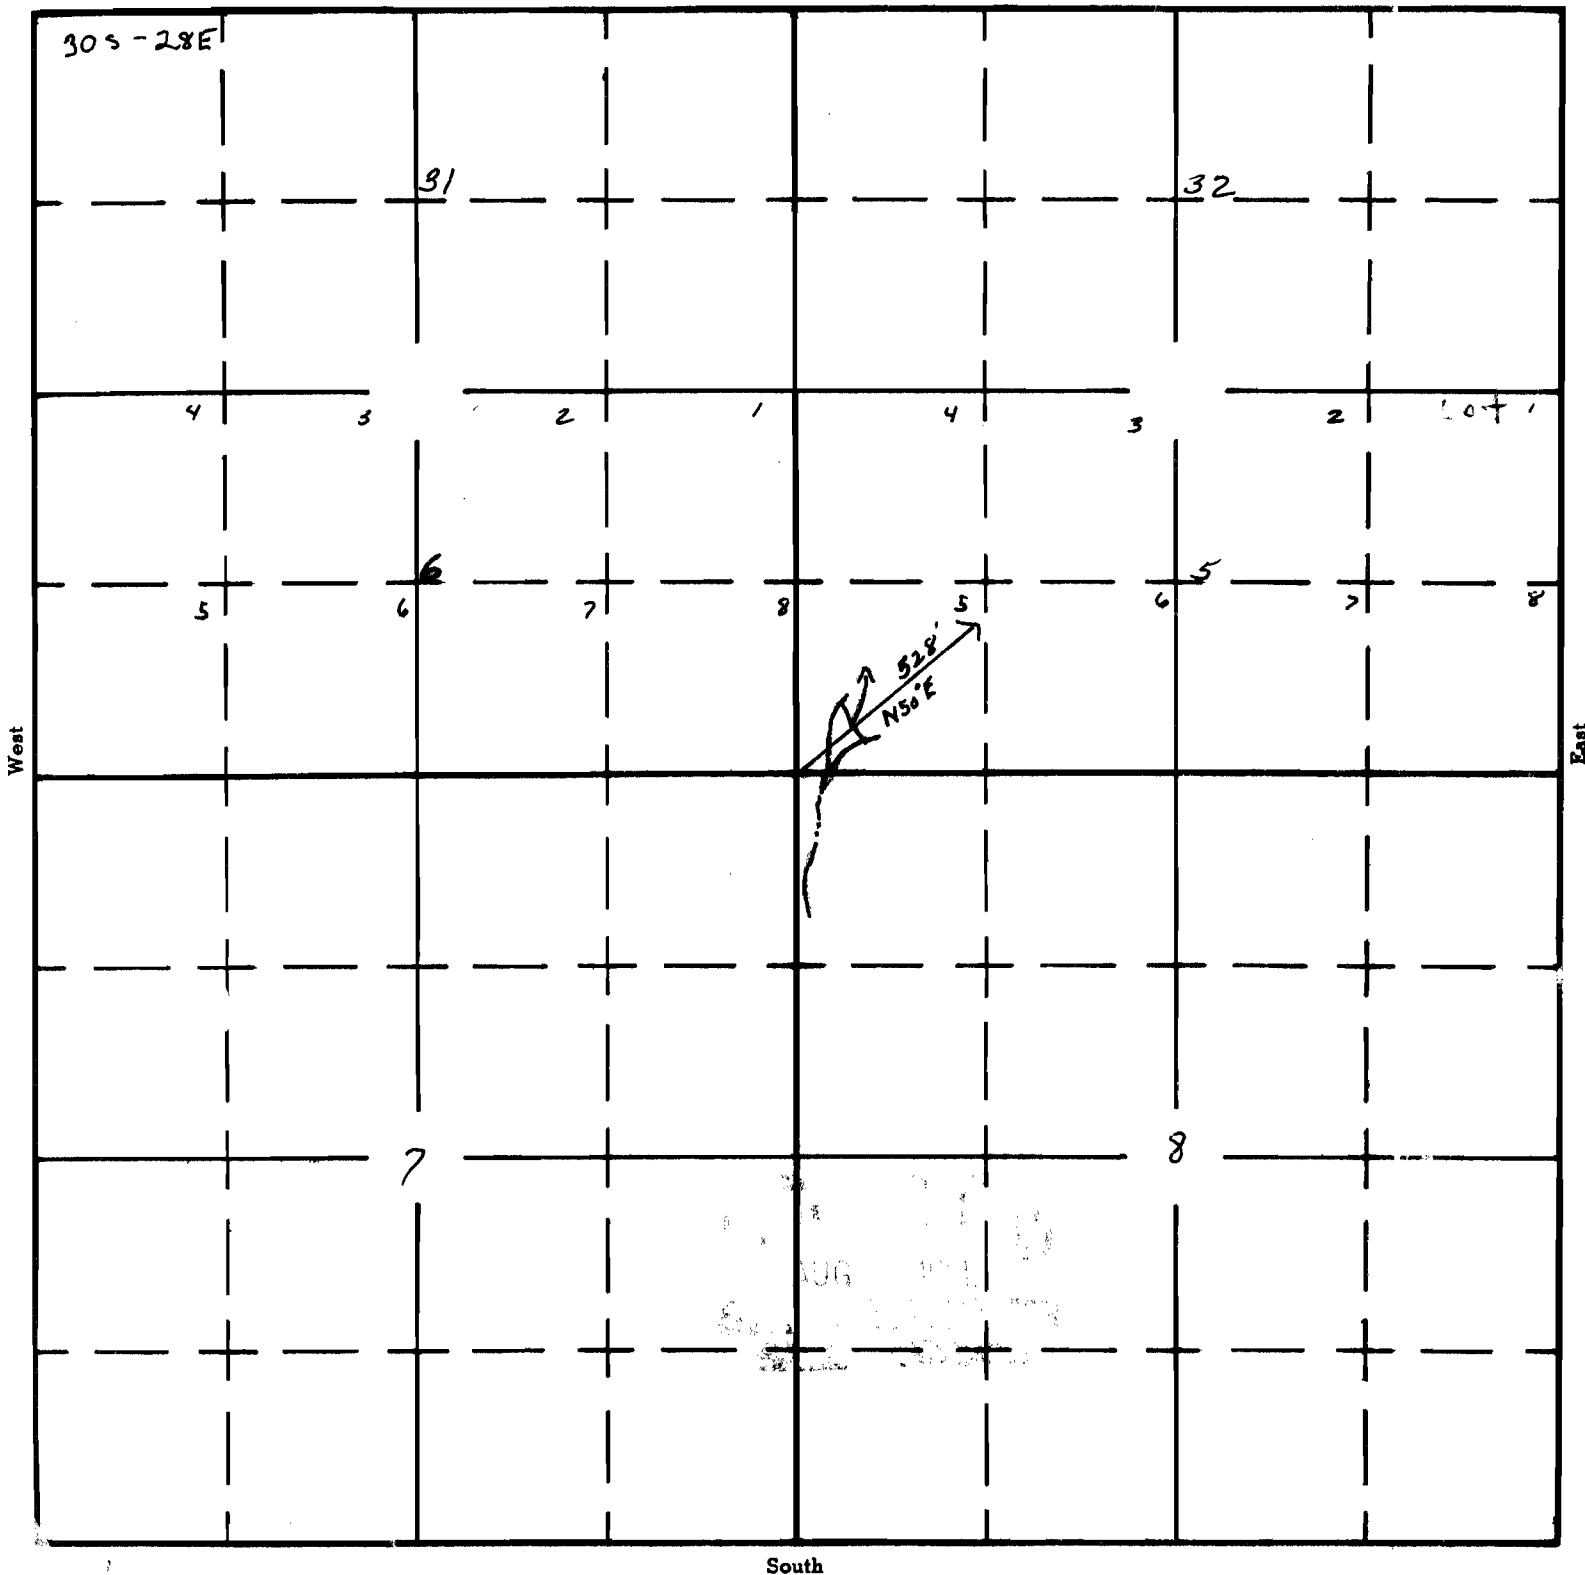

APPLICATION No. R-35953
PERMIT No. R-3532