

Form AI-187
March 1961

UNITED STATES
DEPARTMENT OF THE INTERIOR
BUREAU OF LAND MANAGEMENT

SECTION


SW 1/4 NW 1/4

Oregon State Water Filings

17

TOWNSHIP 38S, RANGE 37E, W. M.

North

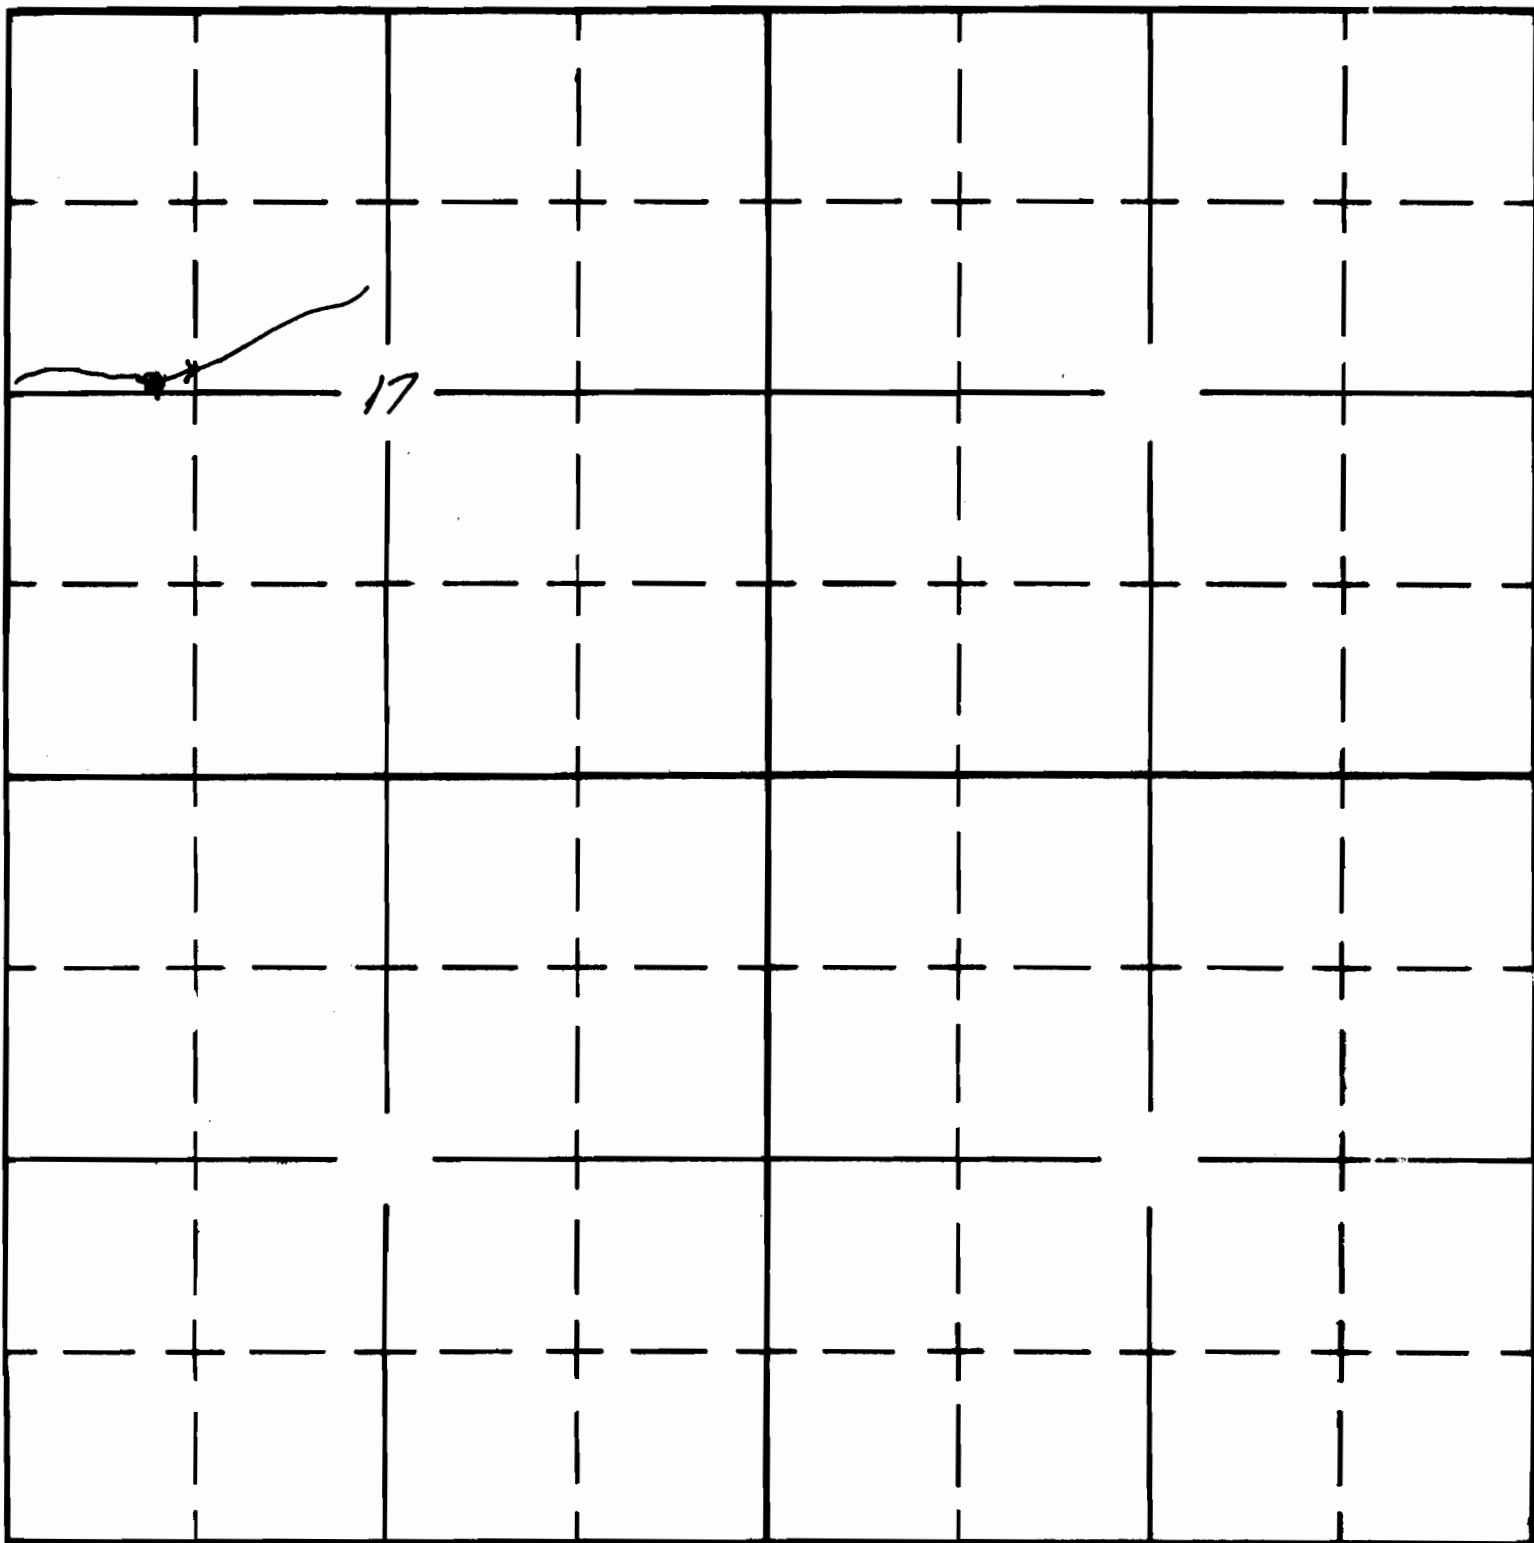

South

APPLICATION No. R-36112
PERMIT No. R-3564