

Form AI-187
March 1961

UNITED STATES
DEPARTMENT OF THE INTERIOR
BUREAU OF LAND MANAGEMENT

SECTION


22

Oregon State Water Filings

NE 1/4 SE 1/4

TOWNSHIP 40 S, RANGE 22 E, W. M.

TIED IN WITH AERIAL PHOTOS AND D.S.H.D. QUAD MAPS.

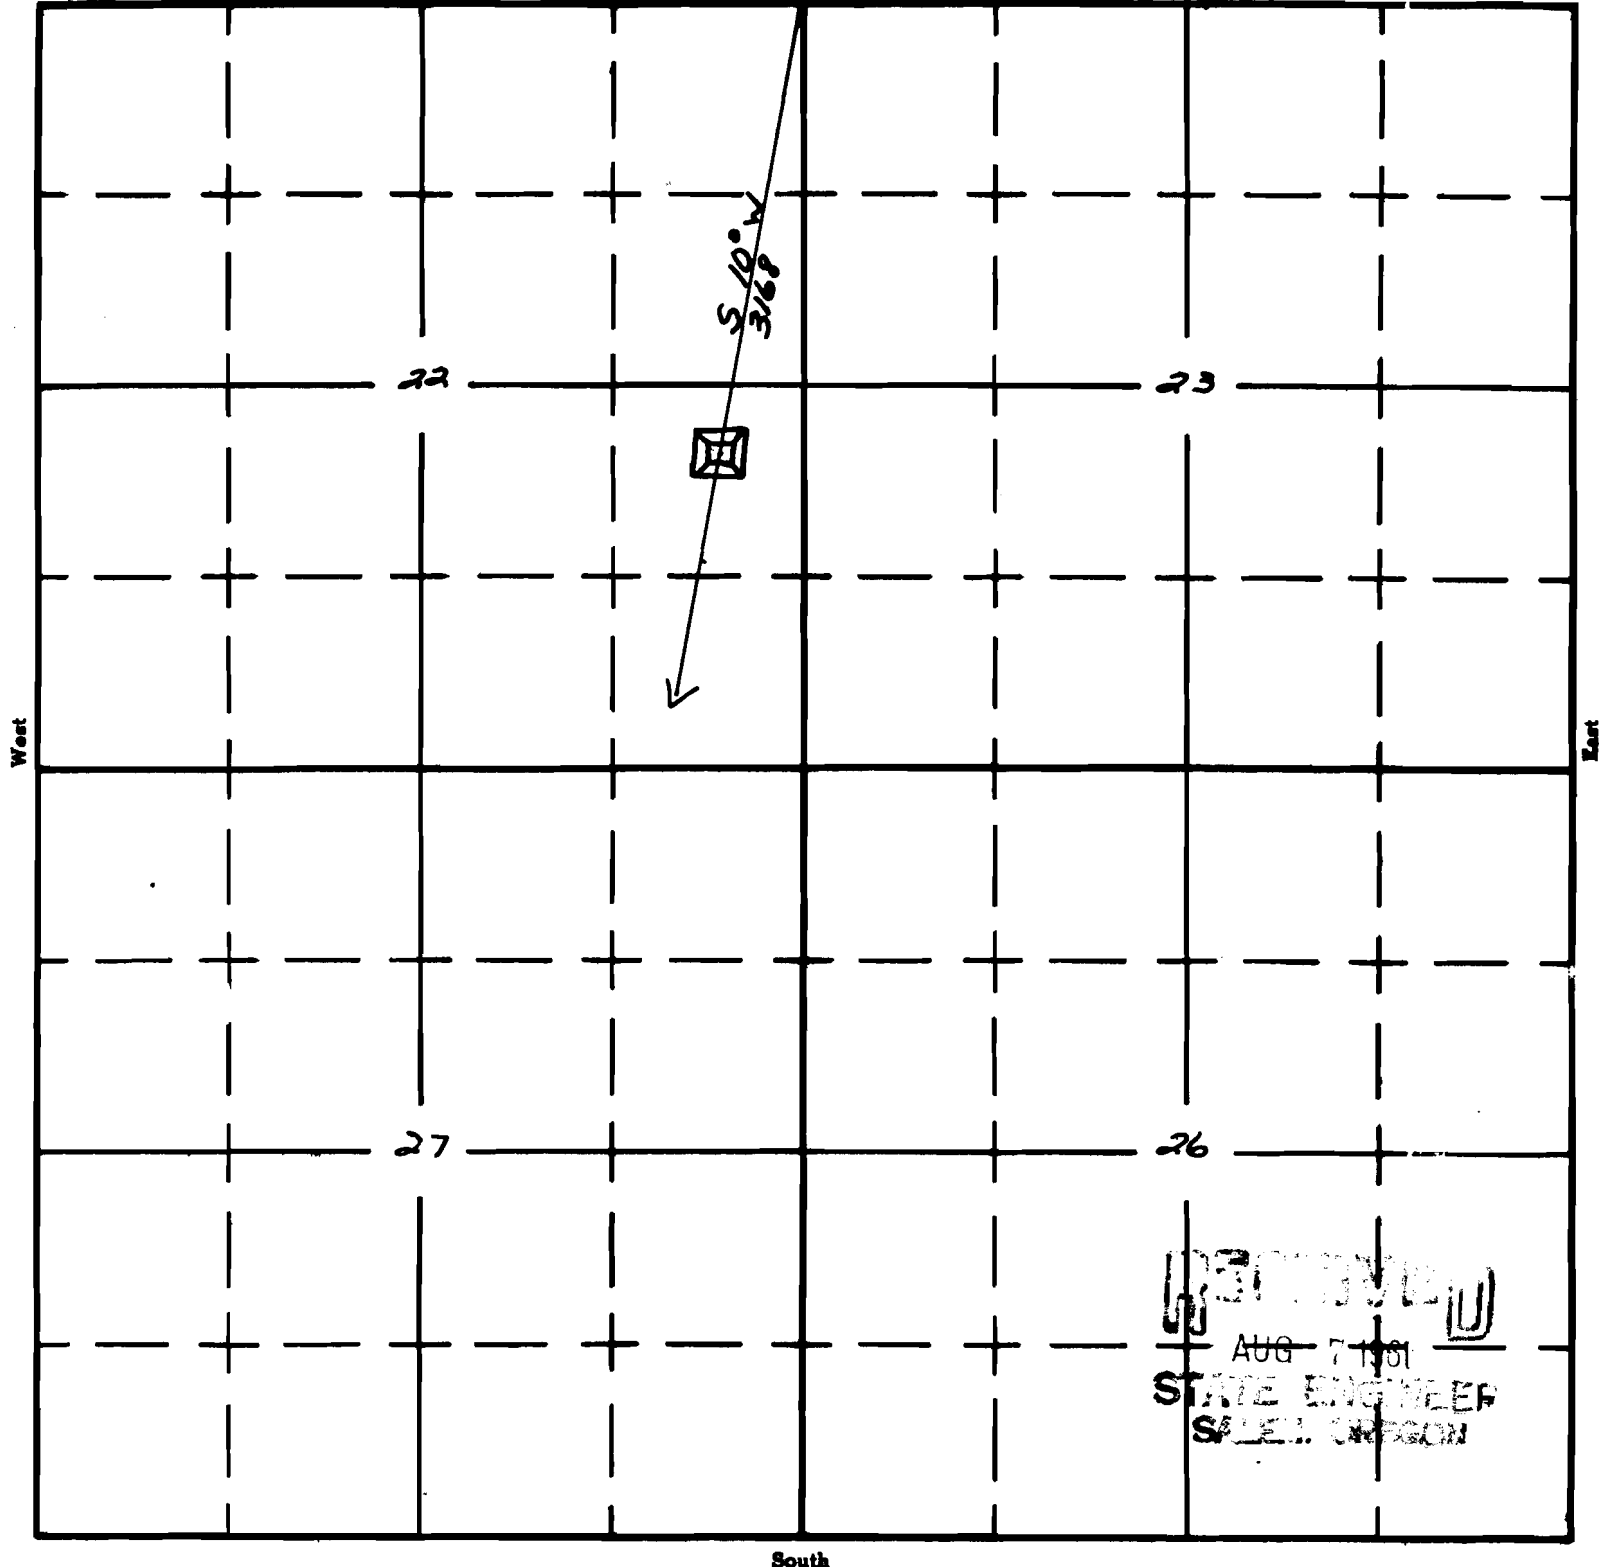

APPLICATION No. R-36316

PERMIT No. R-3615