

Form AI-187
March 1961


UNITED STATES
DEPARTMENT OF THE INTERIOR
BUREAU OF LAND MANAGEMENT

SECTION
22
S&W 1/4

Oregon State Water Filings

TOWNSHIP 28S, RANGE 17E, W. M.

North *ties in with aerial photo and OSND Quad Map.*

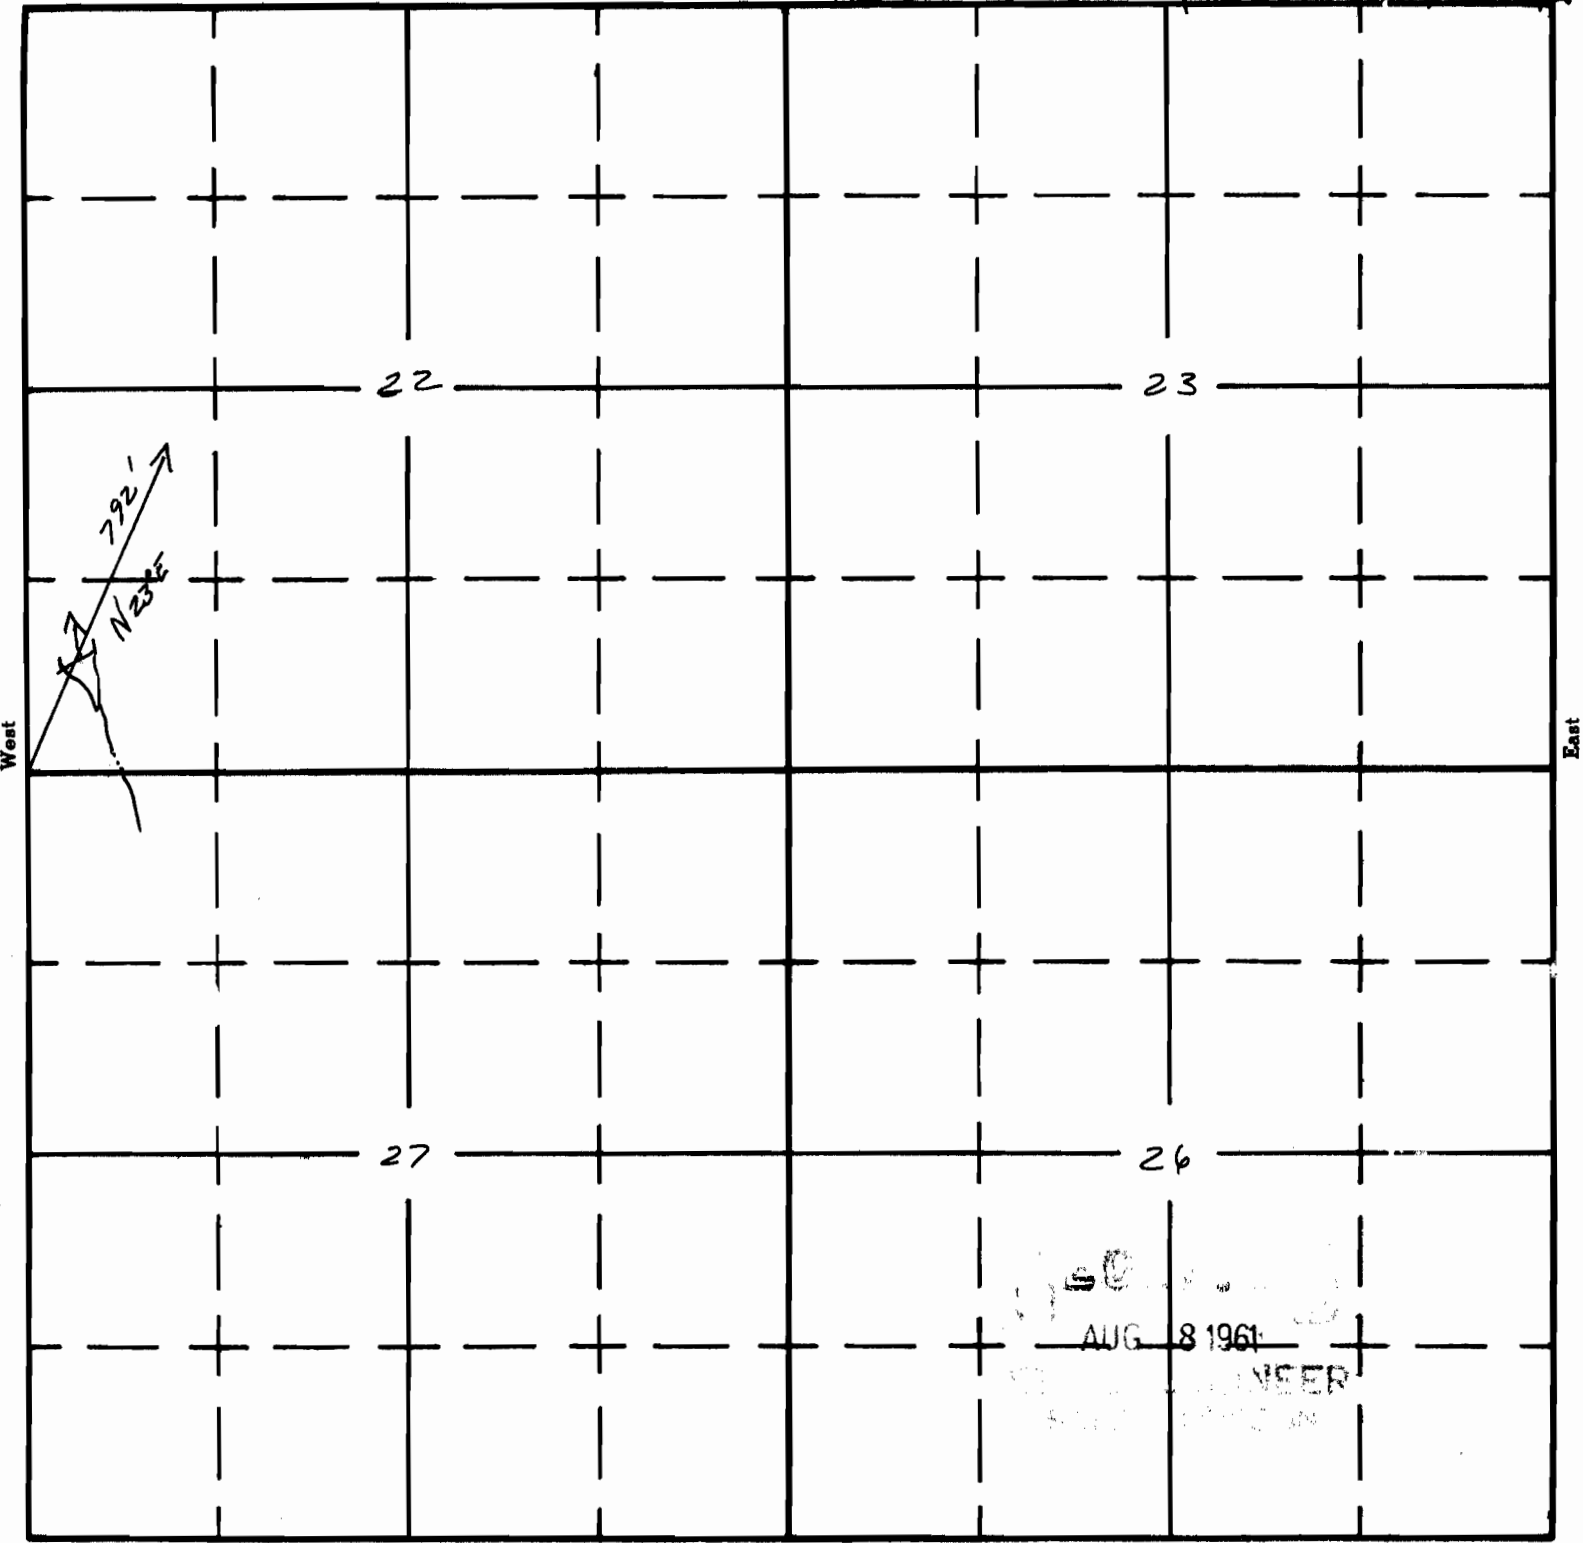

Surveyor's Stamp
AUG 8 1961
ENGINEER
BUREAU OF LAND MANAGEMENT

South

APPLICATION No. R-36552
PERMIT No. 8 7234