

Form A1-187  
March 1961

UNITED STATES  
DEPARTMENT OF THE INTERIOR  
BUREAU OF LAND MANAGEMENT


SECTION


S28

TOWNSHIP 31S, RANGE 43E, W. M.

North

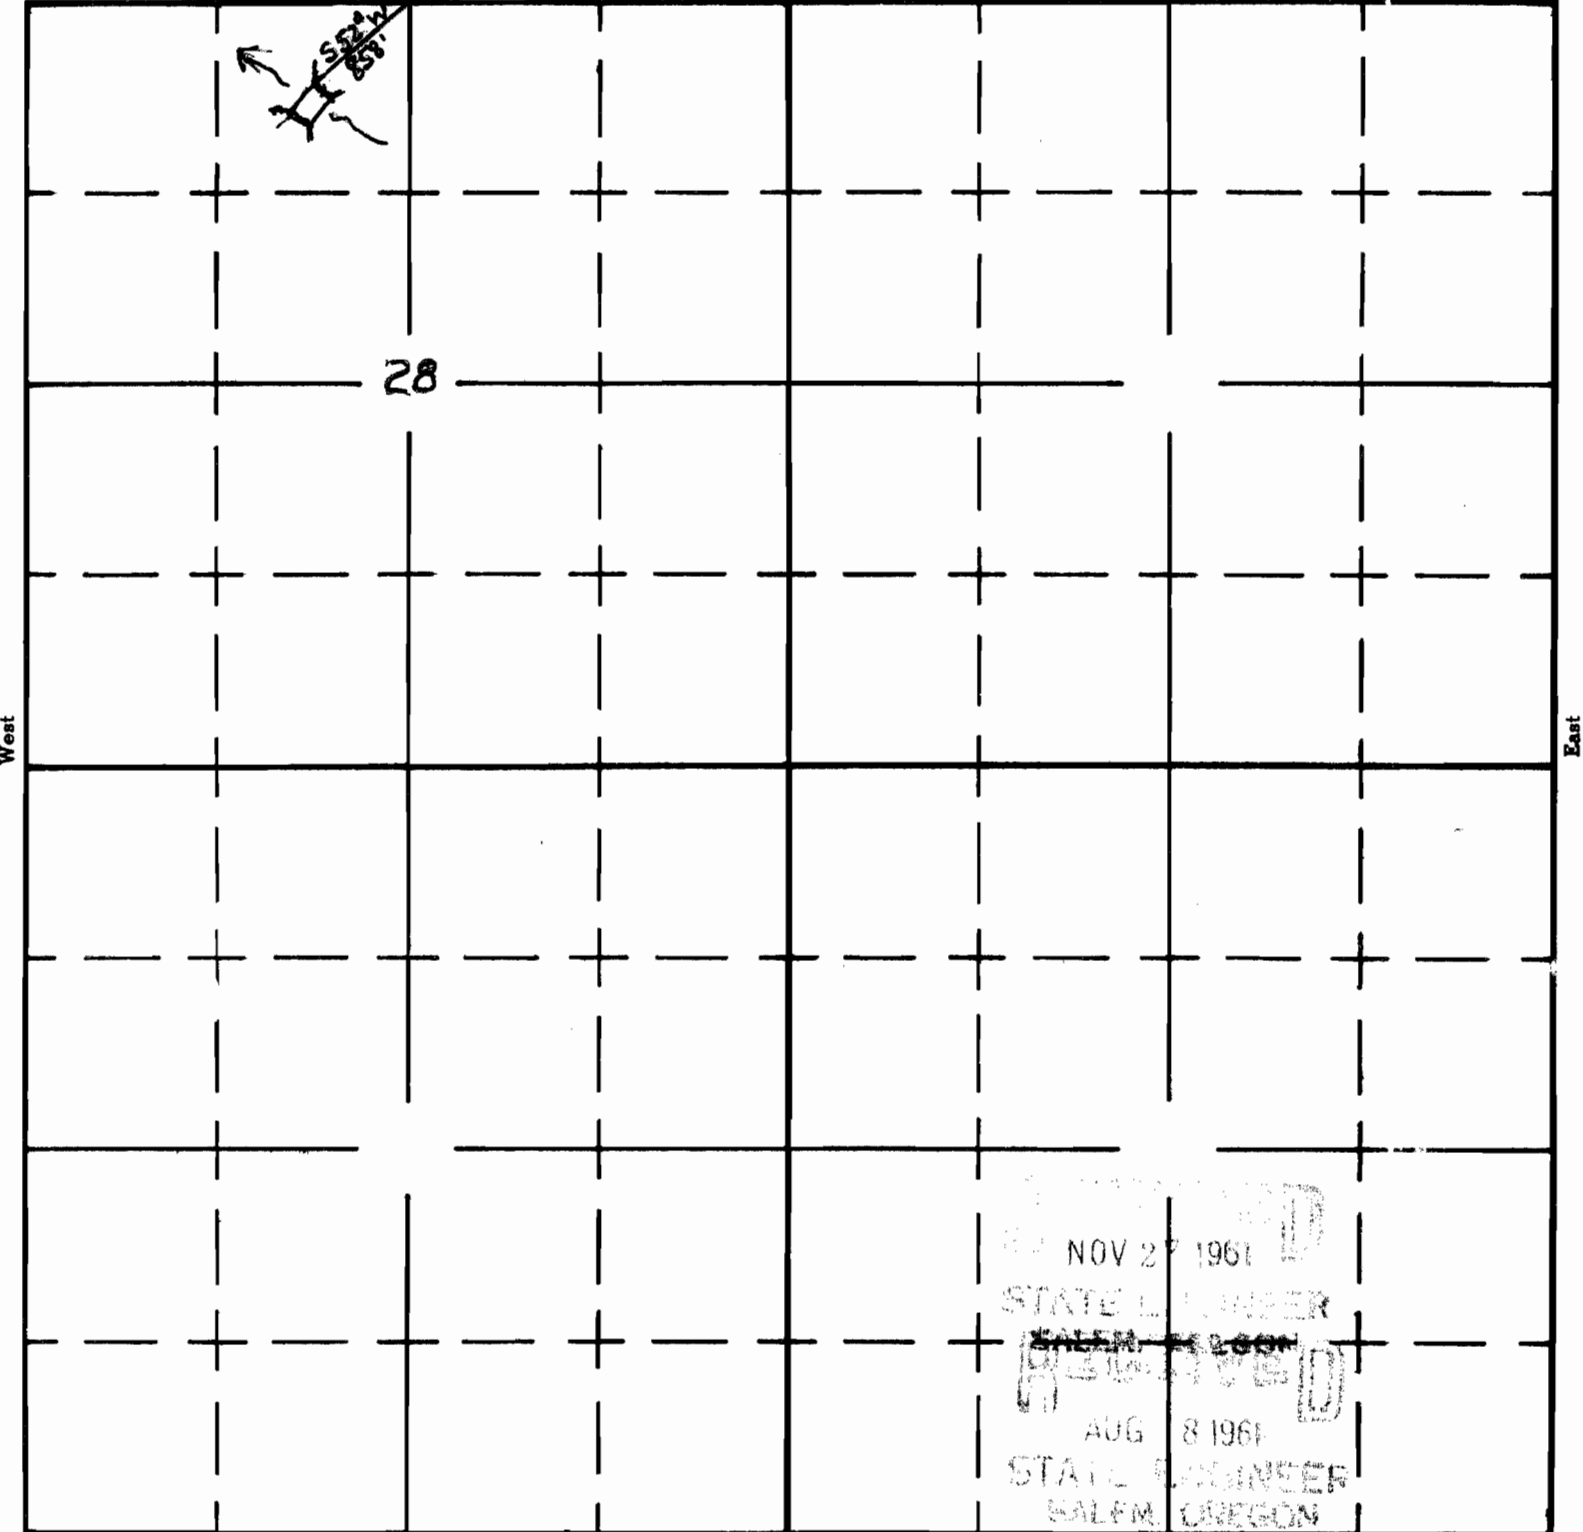

NOV 27 1961  
STATE ENGINEER  
SALEM, OREGON  
AUG 8 1961  
STATE ENGINEER  
SALEM, OREGON

South

APPLICATION No. R-36617  
PERMIT No. R-3510