

UNITED STATES
DEPARTMENT OF THE INTERIOR
BUREAU OF LAND MANAGEMENT

SECTION


14

Oregon State Water Filings

TOWNSHIP 10S, RANGE 42E, W. M.

North

06-411

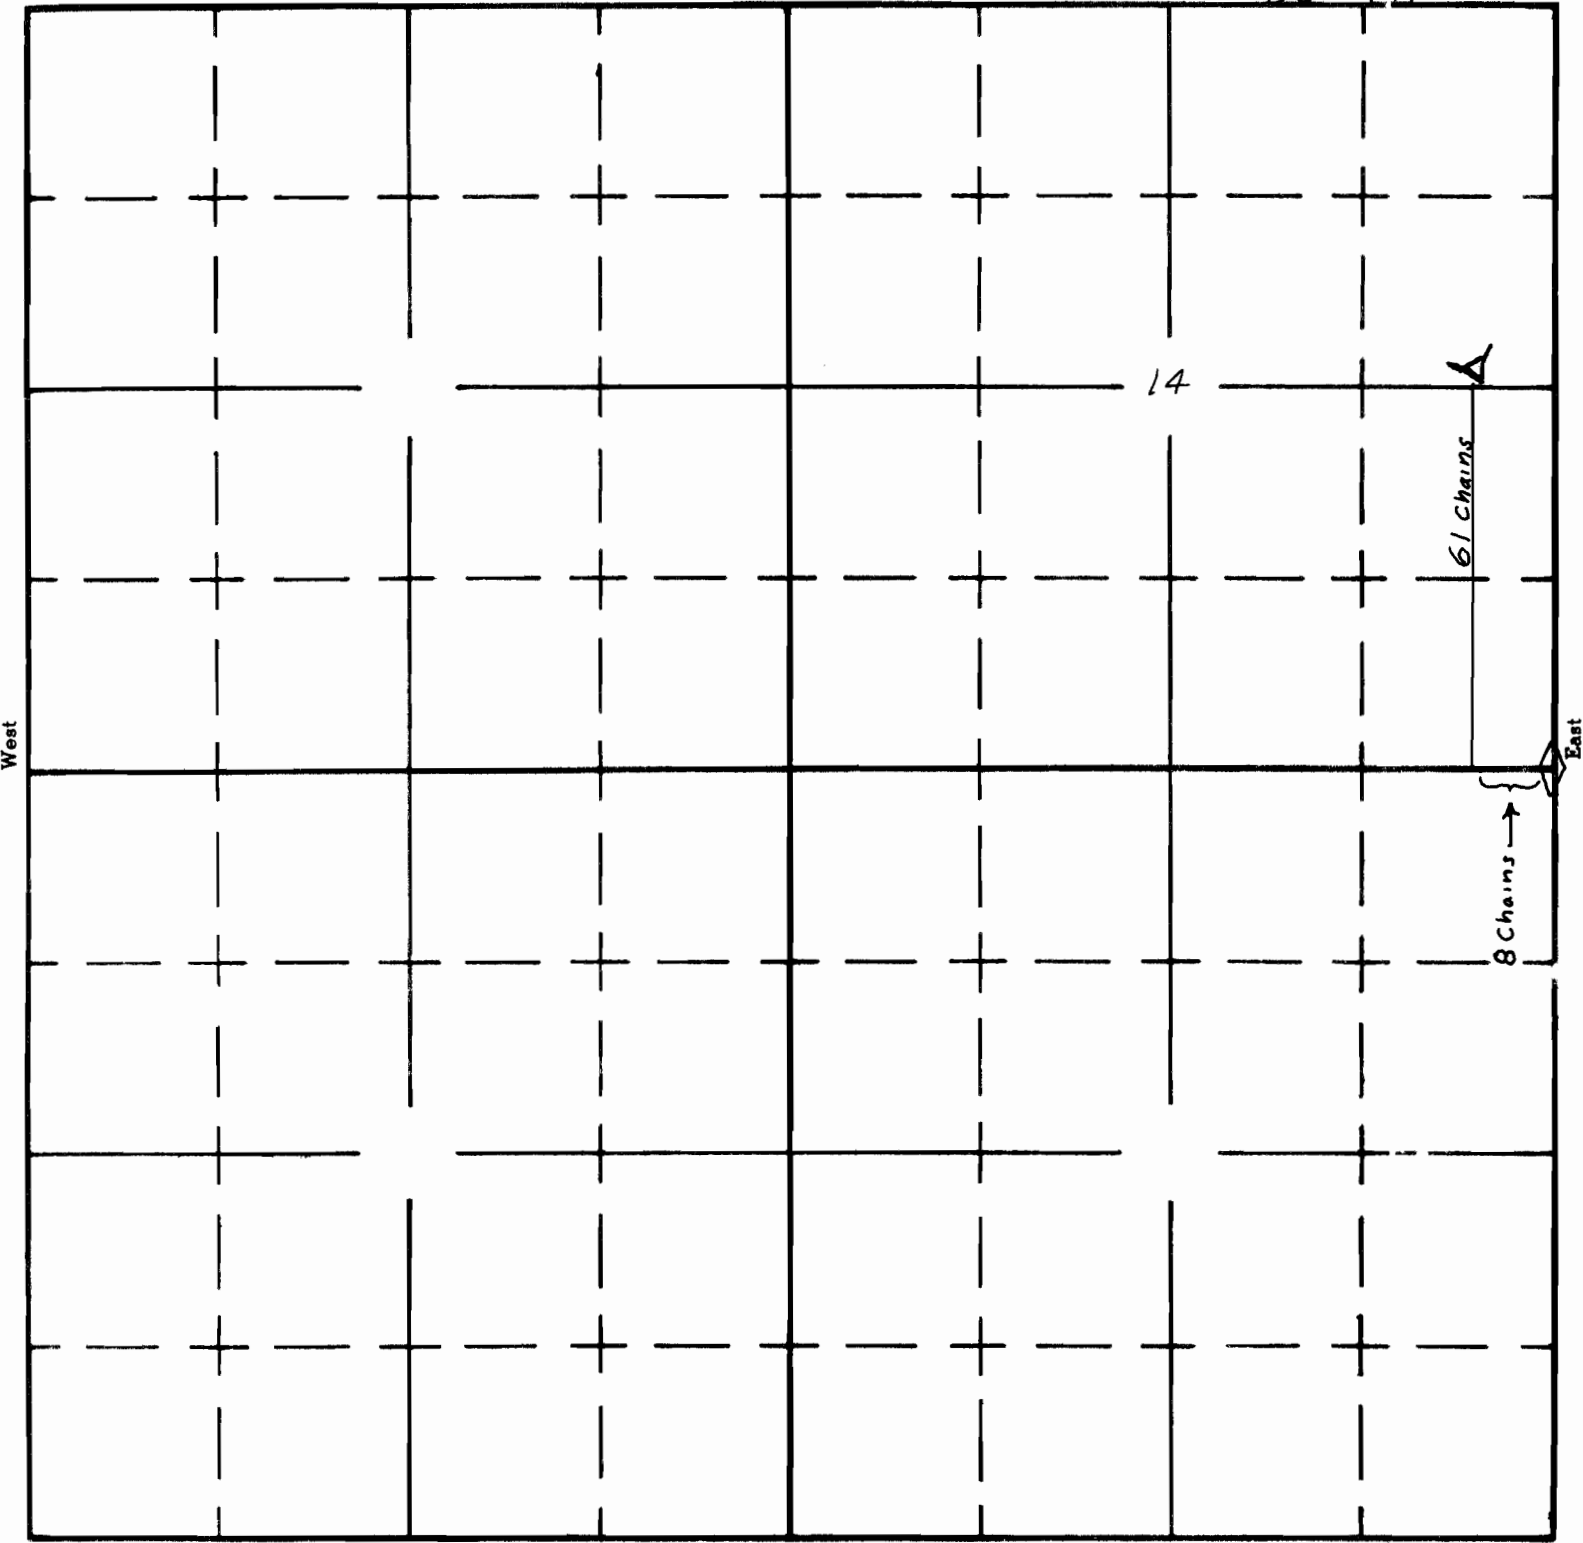

South

APPLICATION No. R-38735

PERMIT No. R-3282