


Sec. 32
33

Tp. 27 S.

R. R. 14 E

7324
7464

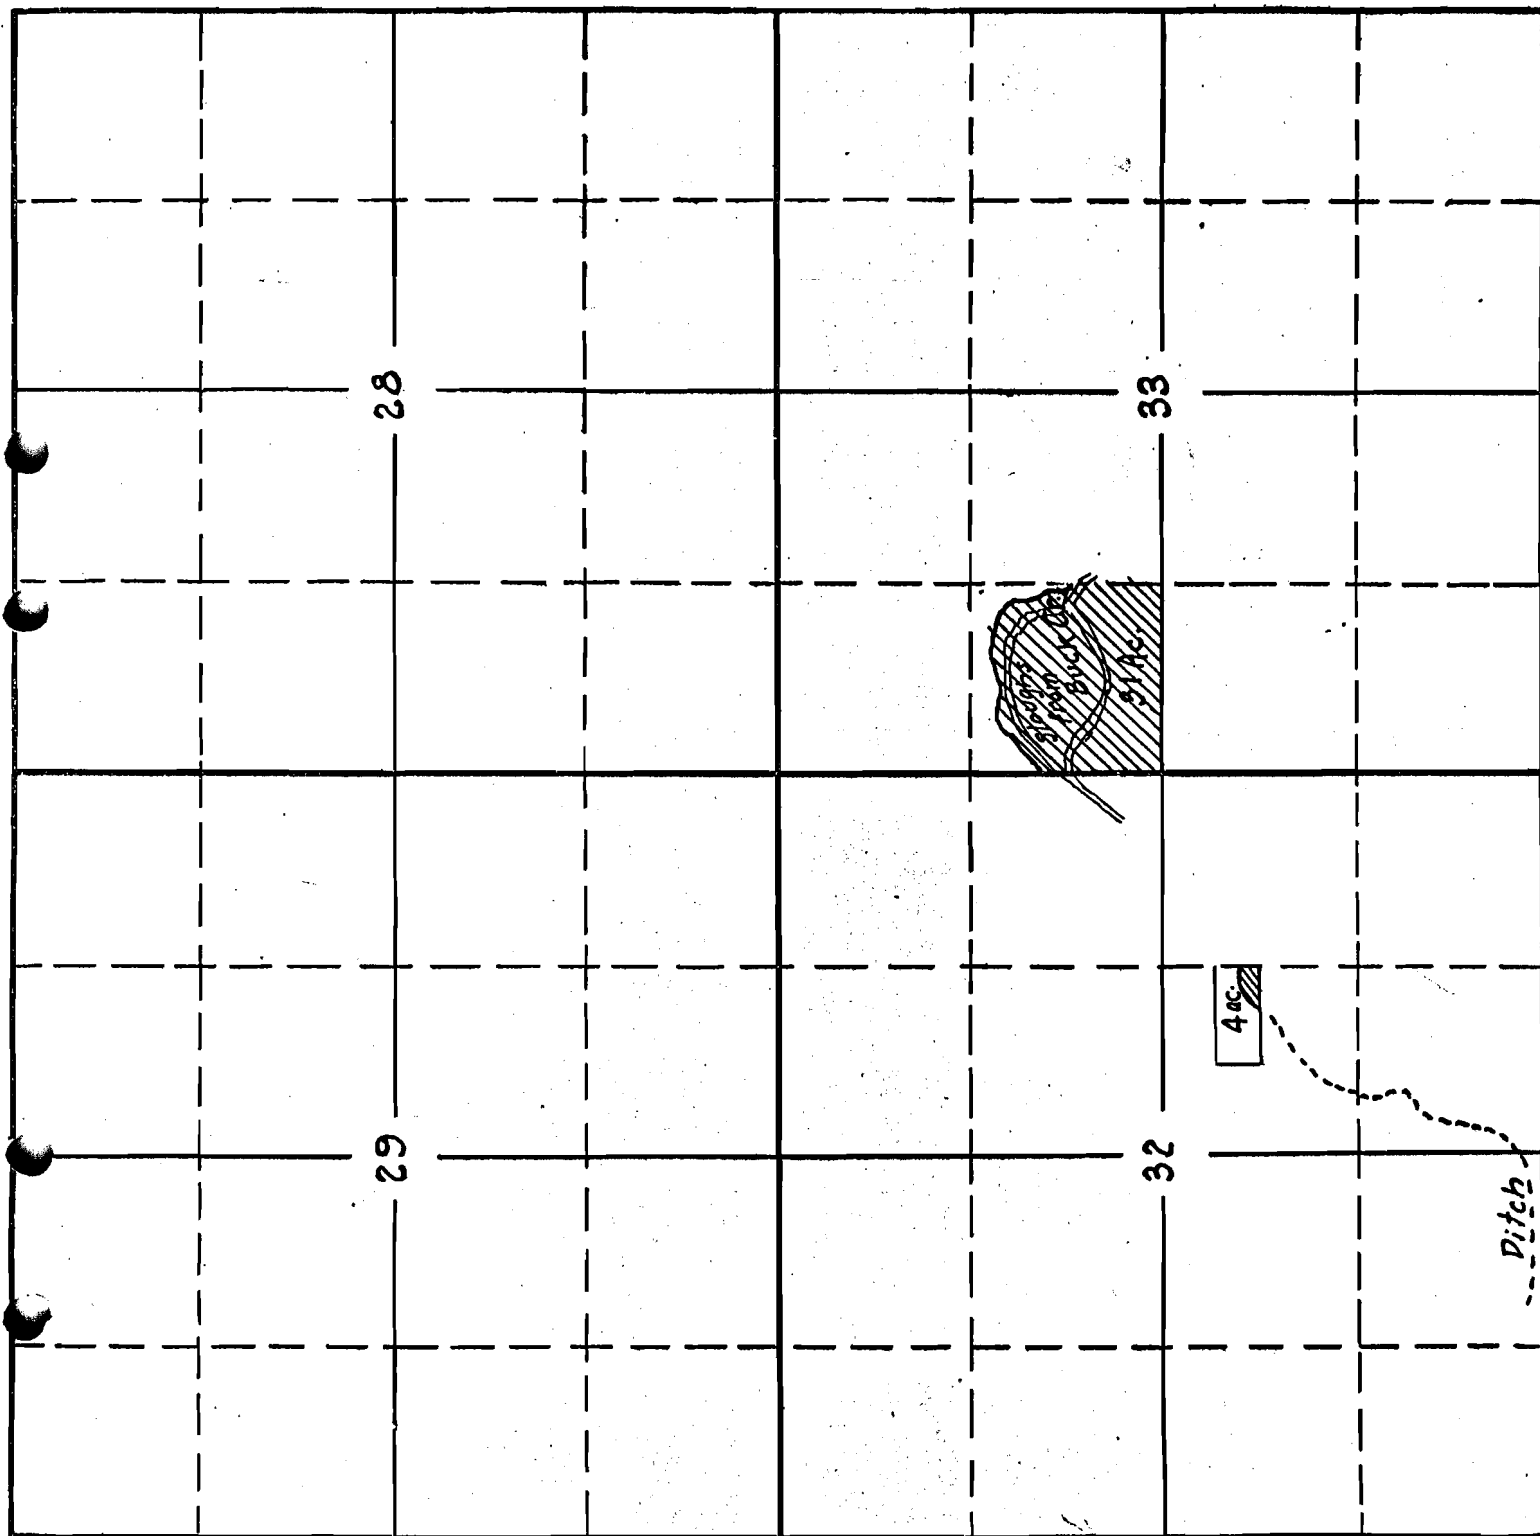

Subd
17-27S-6E

Application No 8971
Permit No 7324
7464