


# T. 15. R. 3 W.W.M.

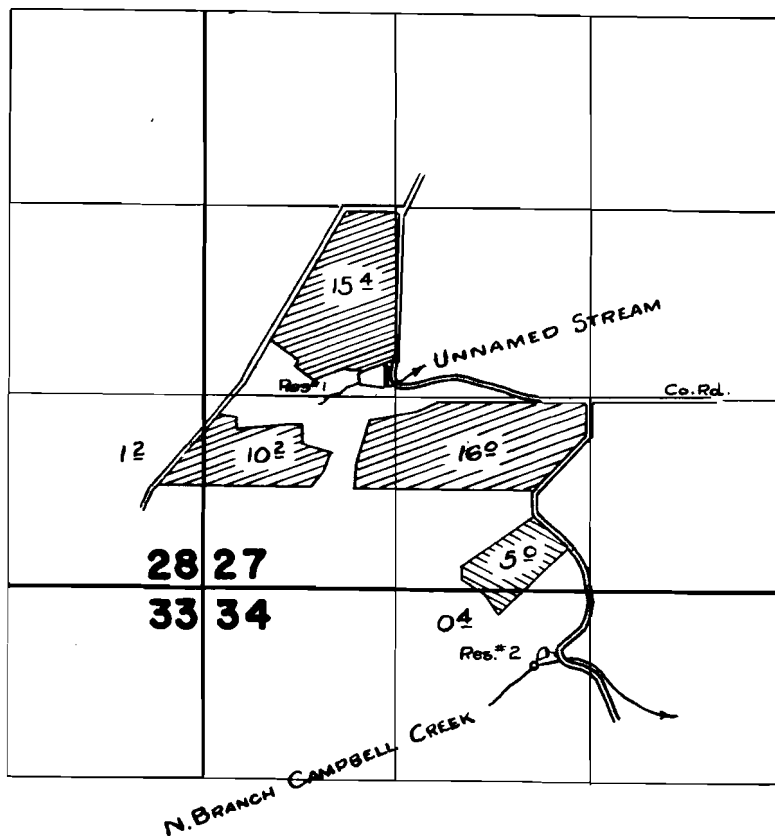

## FINAL PROOF SURVEY UNDER

R 29890                      R-1740  
R-29889                      R-1739  
Application No. 29891    Permit No. 23538  
IN NAME OF

**JOHN KOEHNKE JR.**

Surveyed 25 May 1959, by R. JACKSON

1960-K  
1959-M  
DFR-20-163