



Township 6 South, Range 1 East, W.M.  
 Portions of Sections 7 & 8

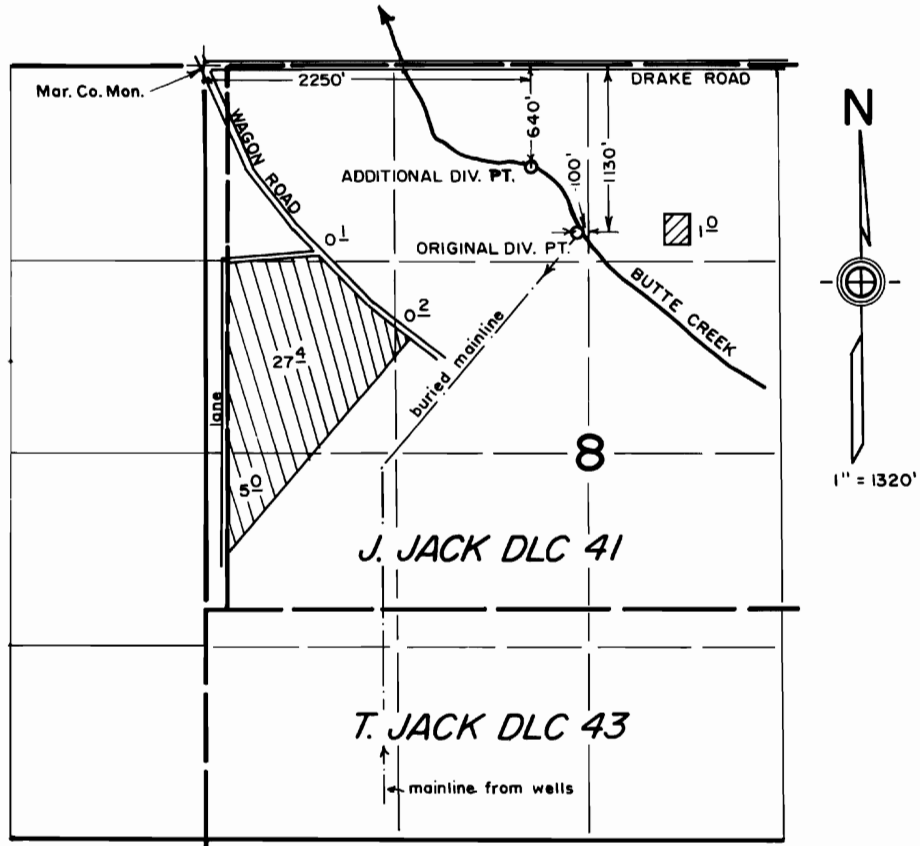

FINAL PROOF SURVEY  
 under  
 Transfer 6360  
 in name of  
 DICKMAN FARMS, INC.  
 December 7, 1992

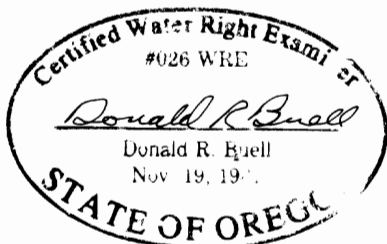

THIS MAP WAS PREPARED FOR THE PURPOSE OF IDENTIFYING THE LOCATION OF A WATER RIGHT ONLY AND IS NOT INTENDED TO PROVIDE LEGAL DIMENSIONS OR LOCATION OF PROPERTY OWNERSHIP LINES.