


T. 6 S., R. 1 E., W. M.

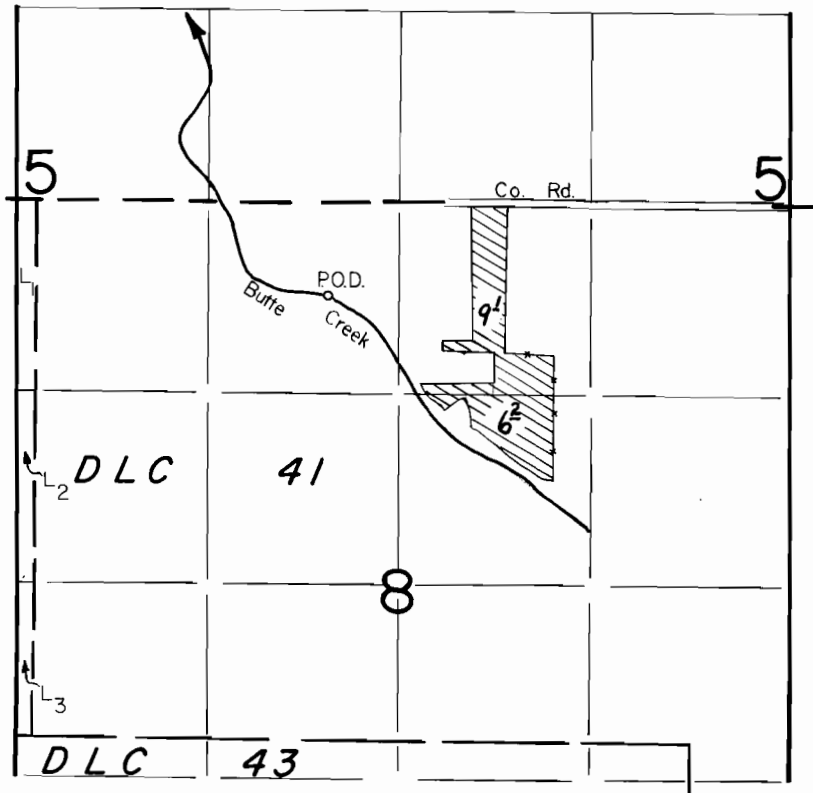

P.O.D. Loc.: 640' S. & 480' W. from N. 1/4 Cor. Sec. 8.

Scale : 1" = 1320'

FINAL PROOF SURVEY UNDER

Application No. ~~68649~~ Permit No. ~~49627~~
IN NAME OF

H. L. "CASEY" & MARJORIE E. JONES

Surveyed Dec. 18, 1989, by T. Warren

41005-278-144C
3/6/90 TMW

REVISED 2/5/92 RWK