


T. 6 S., R. 1 E. W.M.

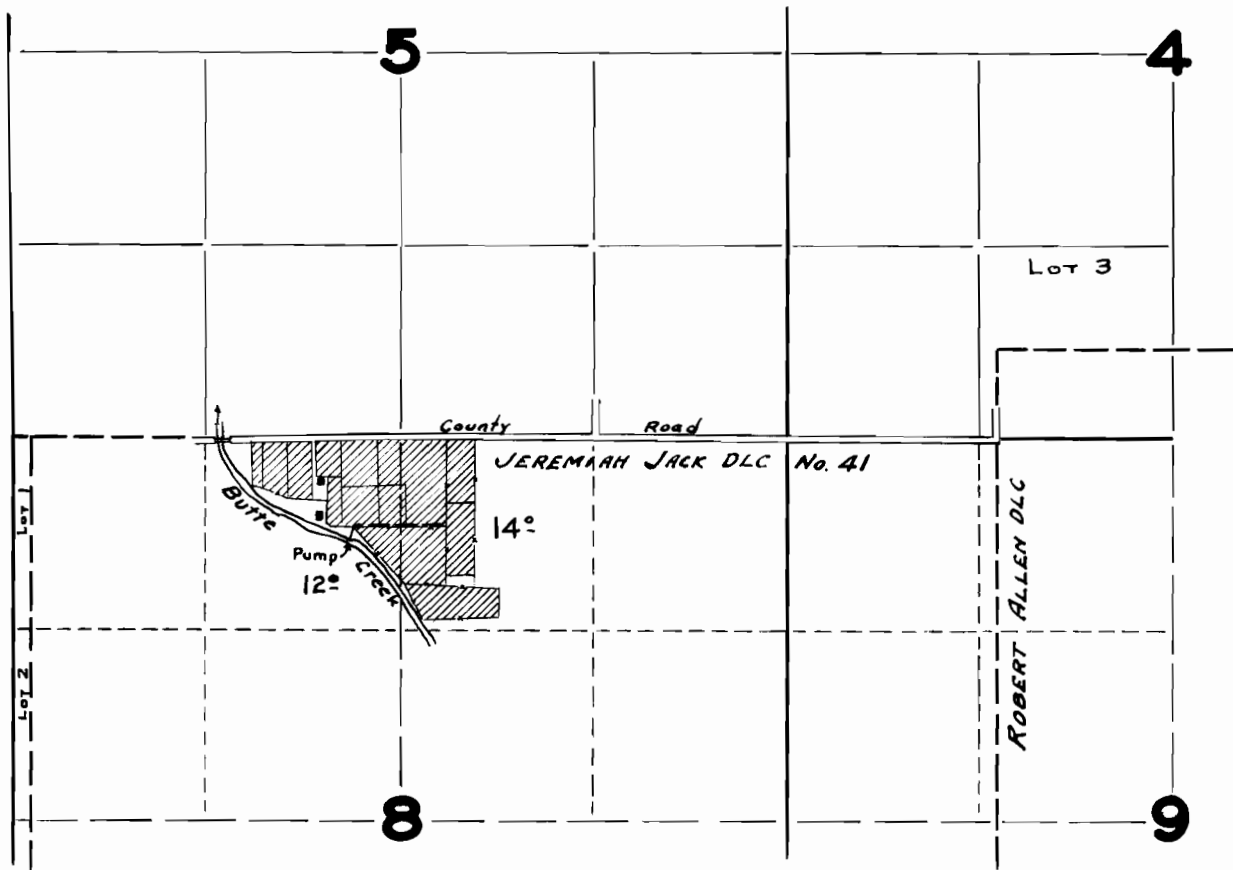

FINAL PROOF SURVEY

UNDER

Application No. 16610 Permit No. 12393

IN FAVOR OF

R. P. Grady

Surveyed July 17, 1942, by Earl Anderson