


# T. 4 N. R. 29 E. W. M.

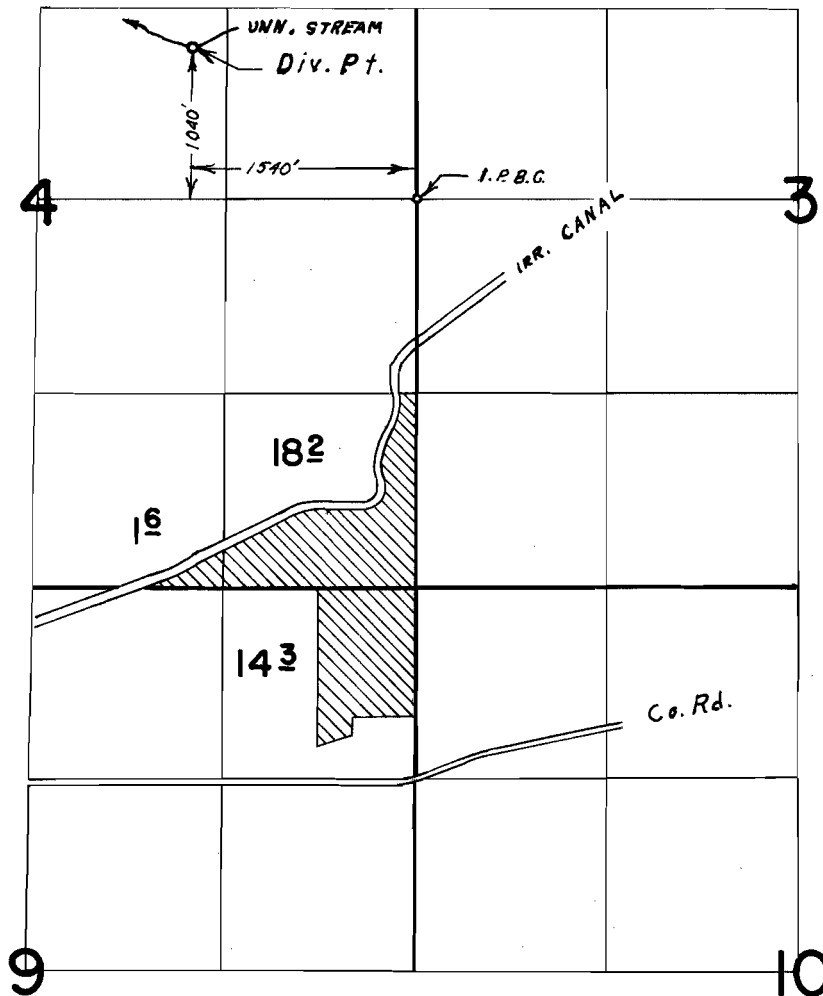

## FINAL PROOF SURVEY UNDER

Application No. 43869... Permit No. 32554...  
IN NAME OF

CHARLES L. HUNT

Surveyed AUG. 31, 1971, by L. E. Gould