


G 5221

74666

44778

T.4N. R.29E. W.M.

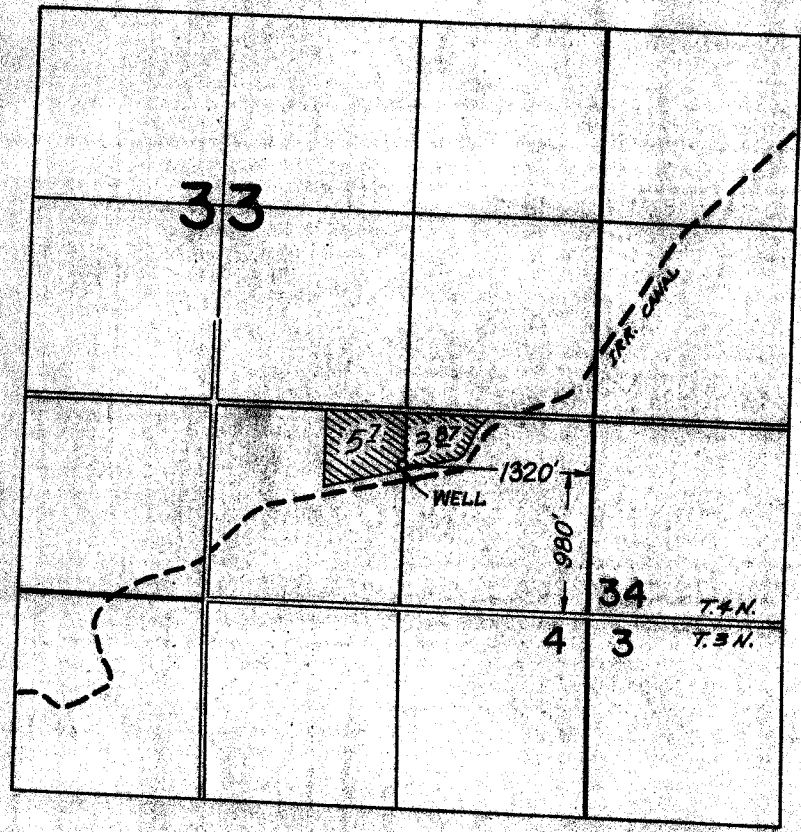

FINAL PROOF SURVEY UNDER

Application No. 66216 Permit No. 95221
IN NAME OF

AUSTIN A. ALFORD

Surveyed March 31 1975, by R.G. MUCKEN