

T.20S. R.21E.
SEC. 21



R-51456 R-7569

T.23S. R.23E.
SEC. 30



R-51422 R-7548


T.20S. R.21E.
SEC. 36



R-51396 R-7528

+ SE SEC. COR.


T.16S. R.24E.
SEC. 10

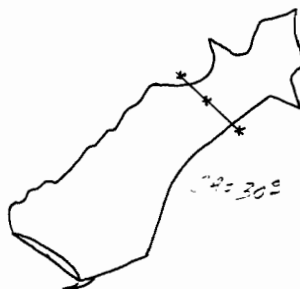

R-51477 R-7590

T.15S. R.23E.
SEC. 34

+ NE SEC. COR.

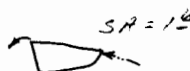

R-51452 R-7567

1" = 1320'
FINAL PROOF SURVEY
UNDER

Application No. Permit No.
IN NAME OF

..... U.S.D.I. BLM.

Surveyed 1980, by L.H. NUNN.....