


SECTION 14

SE $\frac{1}{4}$ SW $\frac{1}{4}$

TOWNSHIP 39S RANGE 39E W.M

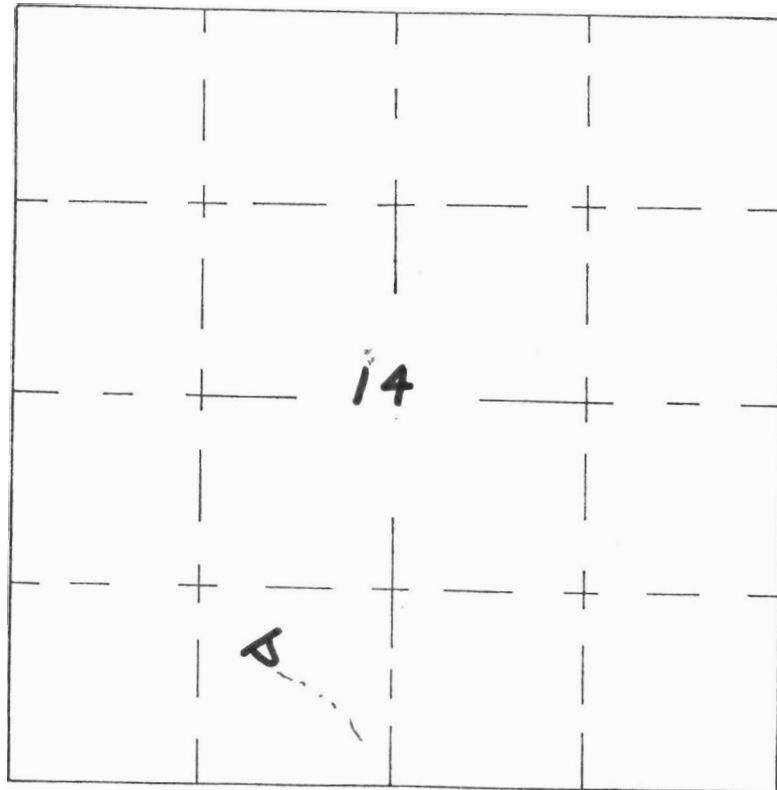

Say When Res.
N^o R 59064

Permit No. R 8709