


RECEIVED
JUN 1979
WATER
DEPT

T. 20 S. R. 30 E. W.M.

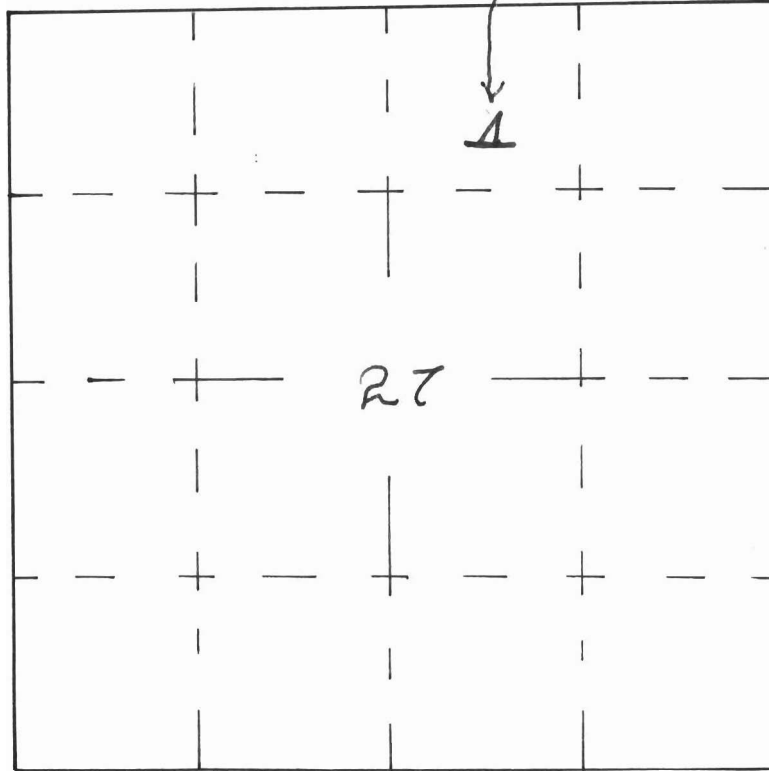

Application No. R59070

Permit No. R 8745

U. S. DEPARTMENT OF THE INTERIOR
BUREAU OF LAND MANAGEMENT

HEIFER

DESIGNED _____

RECOMM. _____

DRAWN _____

RECOMM. _____

CHIEF, DIV. OF ENG.

CHECKED _____

APPROVED _____

SCALE _____

DATE _____

SHEET _____ OF _____

DRAWING NO. _____