


FORM 76  
WATER CONTROL DIST.

SECTION 25

SW<sup>1</sup>/<sub>4</sub> SW<sup>1</sup>/<sub>4</sub> TOWNSHIP 32<sup>S</sup> RANGE 42<sup>E</sup> W.M.

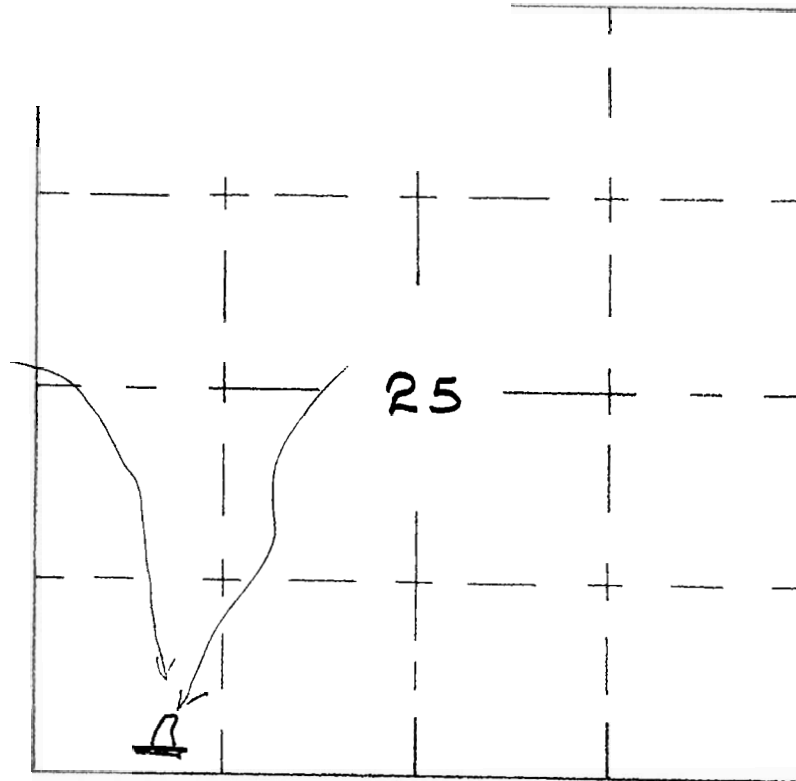

Application No. R59073

Permit No. R 8718

U. S. DEPARTMENT OF THE INTERIOR  
BUREAU OF LAND MANAGEMENT

HANG UP

DESIGNED \_\_\_\_\_

RECOMM. \_\_\_\_\_

DRAWN \_\_\_\_\_

RECOMM. \_\_\_\_\_

CHIEF, DIV. OF ENG.

CHECKED \_\_\_\_\_

APPROVED \_\_\_\_\_

SCALE \_\_\_\_\_

DATE \_\_\_\_\_

SHEET \_\_\_\_\_ OF \_\_\_\_\_

DRAWING NO. \_\_\_\_\_