


UNITED STATES
BUREAU OF LAND MANAGEMENT
WATER

T. 21 S. R. 40 E. W.M.

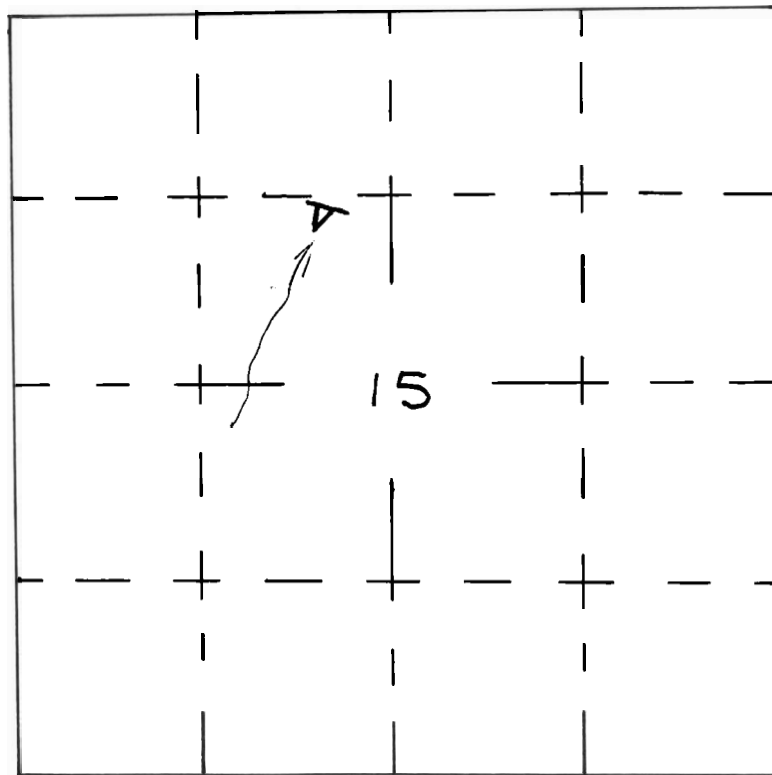

Application No. **R59101**

Permit No. **R 8739**

U. S. DEPARTMENT OF THE INTERIOR
BUREAU OF LAND MANAGEMENT

JASPER

DESIGNED _____

RECOMM. _____

DRAWN _____

RECOMM. _____

CHIEF, DIV. OF ENG.

CHECKED _____

APPROVED _____

SCALE _____

DATE _____

SHEET _____ OF _____

DRAWING NO. _____