


SECTION 32

NE $\frac{1}{4}$ SE $\frac{1}{4}$ TOWNSHIP 22S RANGE 39E WM

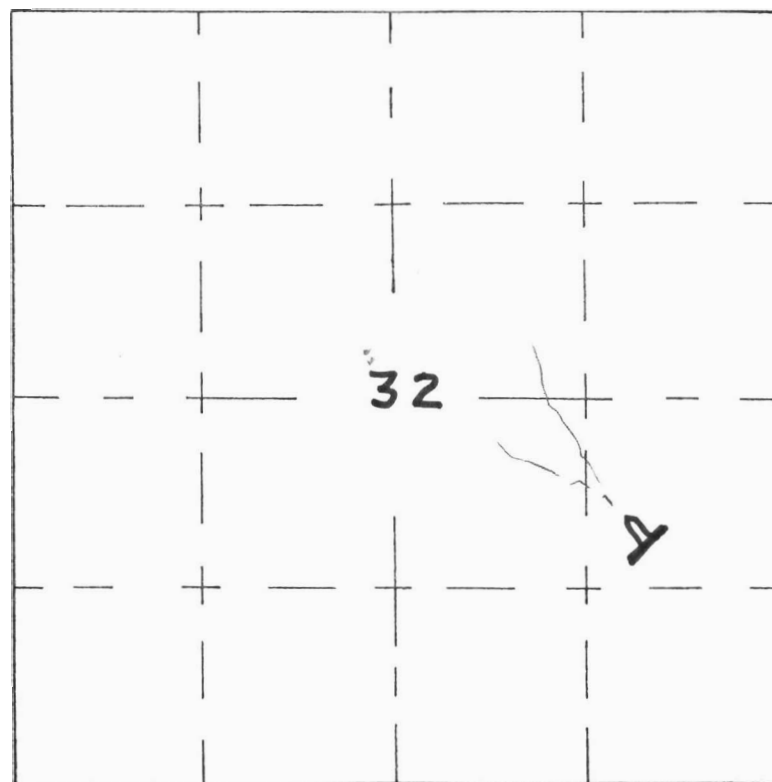

Arrien #1
No R 59114

Permit No. R 8751